


DATE 6/10/17

TOWN OF LEXINGTON — BOARD OF PUBLIC WORKS
WATER DIVISION

Sketch of Service Here

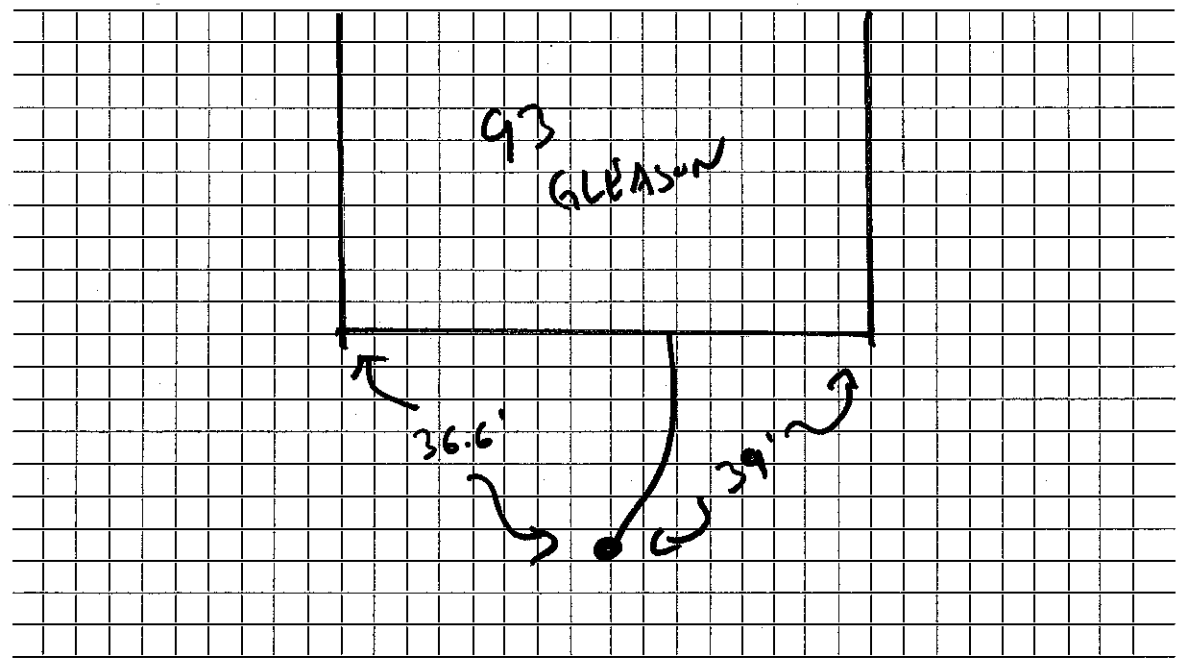

Connection made in GLEASON Street. Work completed TAYLOR EXC.

Remarks:

.....

.....