

Name Harry Howard  
 Address 94 Gleason Road  
 Lexington, Mass.

Service No. 76 #1996  
 # 8783

Location 94 Gleason Road

Kind of Pipe *Recessed*  
~~XXXXXX~~ ~~XXXXXX~~ ~~New Service~~

Size  
*3/2/50*

Size of Main  
 Location

Date	Material	Amount	Total	Date	Material	Amount
May 1, '50	Labor	2.60	2.60	May 1, '50	Labor	10.00
	10% Overhead		26	March 17, 1952	<i>Deposited</i>	25.00
	30' - 3/4" Copper Tubing @.23	6.90	6.90		<i>Plated</i>	2.80
	1 - 3/4" C x 1/2" I.W.H. S&W	3.29	3.29		No Charge	
	Littlefield Shovel 2 hrs. @7.00	14.00	14.00	May 1, '50	Labor	10.00
	Trucking 1 hr. @.75	.75	.75	28' - 3/4" Copper Tubing @.23		6.44
			27.80	1 - 3/4" C Corp-cock		3.15
				1 - 3/4" C x 3/4" C Curb-cock		3.85
				1 - Box & Rod		3.70
				1 - 1/2" Straight Tail Piece		38
				1 - 1/2" Offset Tail Piece		38
				Littlefield Shovel 2 1/2 hrs. @ 7.00		14.00
				Trucking 1 hr. @.75		75
				Patching 25 x 3		25.00
						71.15
	Labor					

TOWN OF LEXINGTON - BOARD OF PUBLIC WORKS

**WATER DIVISION**

The undersigned applies for a supply of water at No..... St. and hereby agrees to comply with the rules and regulations as now, or at any future time, established by the Board of Selectmen.

Am't of Estimate \$.....

Owner .....


Am't Paid \$.....

Address .....

Builder .....

.....

Sketch of Service Here

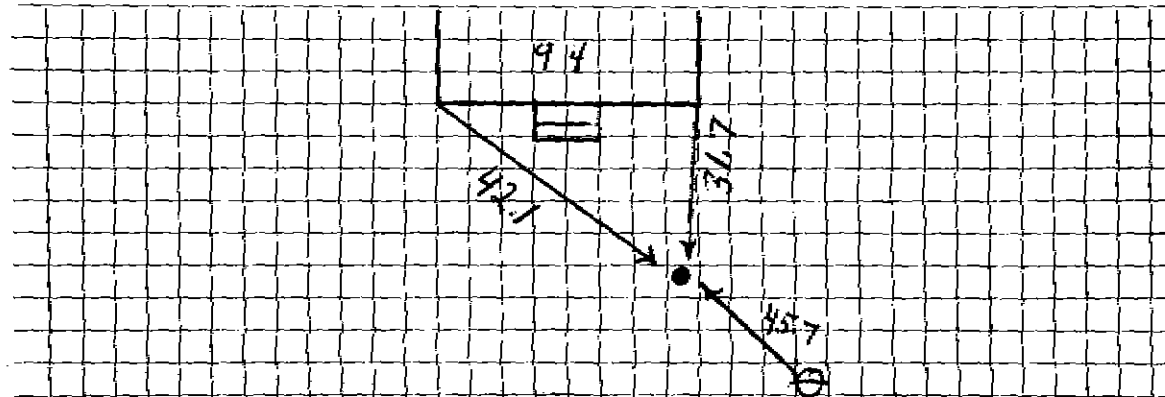

Connection made in ..... Street.

Work completed .....19

Remarks: