

Name Alphonse J. Comeau (Builder)
 Address 307 Beach Street, Belmont, Mass.
 95 Gleason Road

Service No. ~~1030~~ ¹⁶⁰²

Location 95 Gleason Road

Kind of Pipe Size Size of Main

Repair—Renewal—New Service

Location

Date	Material	Amount	Total	Date	Amount
------	----------	--------	-------	------	--------

1941

April 10,	2 hrs. @ 55¢	1 10			
<i>from 4/9/41</i>	24 " @ 60¢	14 40			
	10% Overhead				
	31' 3/4" Copper tubing @ 19¢				
	1 3/4" C.x 1/2" I.S. & W.				
	Trucking - 2 hrs. @ 75¢				

15 50

1 55

5 89

2 25

1 50

26 69

April 2, 1941 Deposited
June 13, 1941 Repaid

57 00

23 91

26 69

Labor

DATE Mar 27, 1941

TOWN OF LEXINGTON—BOARD OF PUBLIC WORKS

WATER DIVISION

The undersigned applies for a supply of water at No. 95 Gleason Rd St. and hereby agrees to comply with the rules and regulations as now, or at any future time, established by the Board of Selectmen.

Am't. of Estimate \$

Owner

Leon E. Herregodts

Am't. Paid \$


Address

309 Mystic St

Builder A. J. Soneaux
307 Beach St Belmont.

Wilmington

Sketch of Service Here

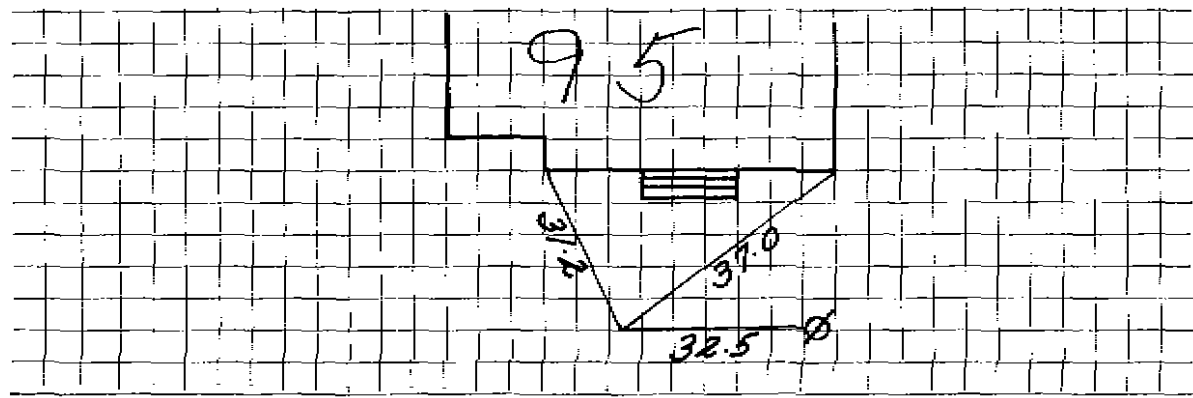

Connection made in _____ Street.

Work completed _____ 19

Remarks: