

## WATER SERVICE RECORD

Name Ernest E. Outhet

Service No. 14

Address 99 Gleason Road

# 4337  
# 5844

Location


~~Repair - General~~ - New Service

Date	Material	Amount	Total	Date	Amount
4/2/56	Labor	3 55		2-24-56	Deposit \$ 50 00
	10% overhead	36	3 91	5-21-56	Applied to S.H.C. #9 18 92
	33' - 3/4" Copper tubing @ .4850	16 00			NON CHARGE Ref 5 46
	1 - 3/4Cx $\frac{1}{2}$ I.W.H. Stop & Waste	4 96	4 96	4/2/56	Labor 1 90
	1 hr. trucking		75	12' - 3/4" Copper tubing @ .4850	5 82
			25 62	1 - 3/4C. Corp Cock	4 34
				1 - 3/4C. Curb Cock	6 03
				1 Box & Rod	4 62
				1 - $\frac{1}{2}$ Straight tailpiece	50
				1 - $\frac{1}{2}$ Offset tailpiece	50
					23 71

DATE \_\_\_\_\_

TOWN OF LEXINGTON — BOARD OF PUBLIC WORKS  
**WATER DIVISION**

Sketch of Service Here

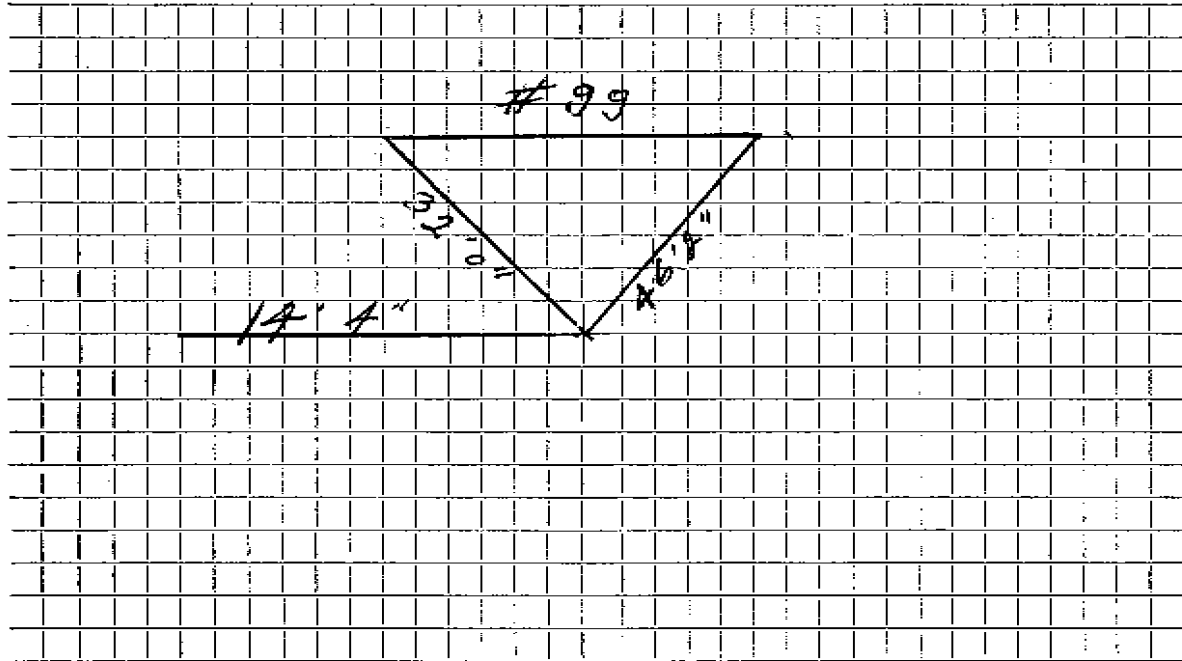

Connection made in ..... Street. Work completed .....

Remarks: .....

.....

.....