

WATER SERVICE RECORD

Name

Service No.

Address Block 7 Lot 5 Gleason Rd.

Location

~~Repair-Renewal~~ New Service SERVICE IMPROVEMENT


Date	Material	Amount	Total	Date	Amount
9-16-47	25' 3/4" Copper				
	1 3/4" X 1/2" I.W.H. Stop + Waste				
				10/21/55	
				Label	1 75
				14' - 3/4" Copper pipe no. 3628	5 38
				1 - 3/4" C. curb-block	4 33
				1 - 3/8" C x 3/4" C. curb-block	4 67
				1 box curb pipe	3 90
				1 lb. bucking	75
					20 45

DATE \_\_\_\_\_

TOWN OF LEXINGTON — BOARD OF PUBLIC WORKS

**WATER DIVISION**

Sketch of Service Here

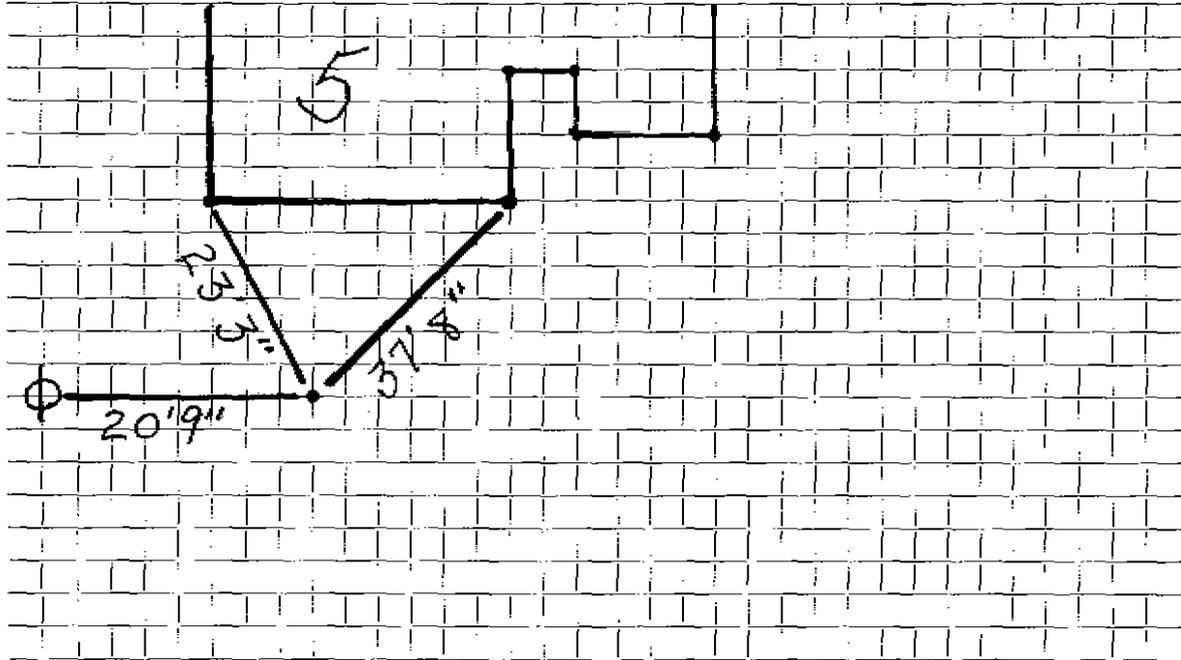

Connection made in ..... Street. Work completed .....

Remarks: .....

.....

.....