

WATER SERVICE RECORD

#7733

Name Istvan L. Ver

Service No. 11

Address 10 Glen Road

Location Mail to: 45 Mt. Vernon St., Arlington

Repair—Renewal—New Service

WO # 664 - Lexington Sewerage # 2304

Comm 10-23-73


Date	Material	Amount	Total	Date	Amount	
4/5/73	Labor	17 22		4-5-73	Deposit	150 00
	10% O.H.	1 72	18 94	4-23-73	Refund	80 25
	15' 1" copper @	77	11 55			49 45
	1 1" corporation		13 79			
	1 1" curb cock		14 43			
	1 Box and Rod		7 34			
	1 hour truck @	3 00	3 00			
			69 05			
4-13-73	83' 1" copper					

DATE _____

TOWN OF LEXINGTON — BOARD OF PUBLIC WORKS

WATER DIVISION

Sketch of Service Here

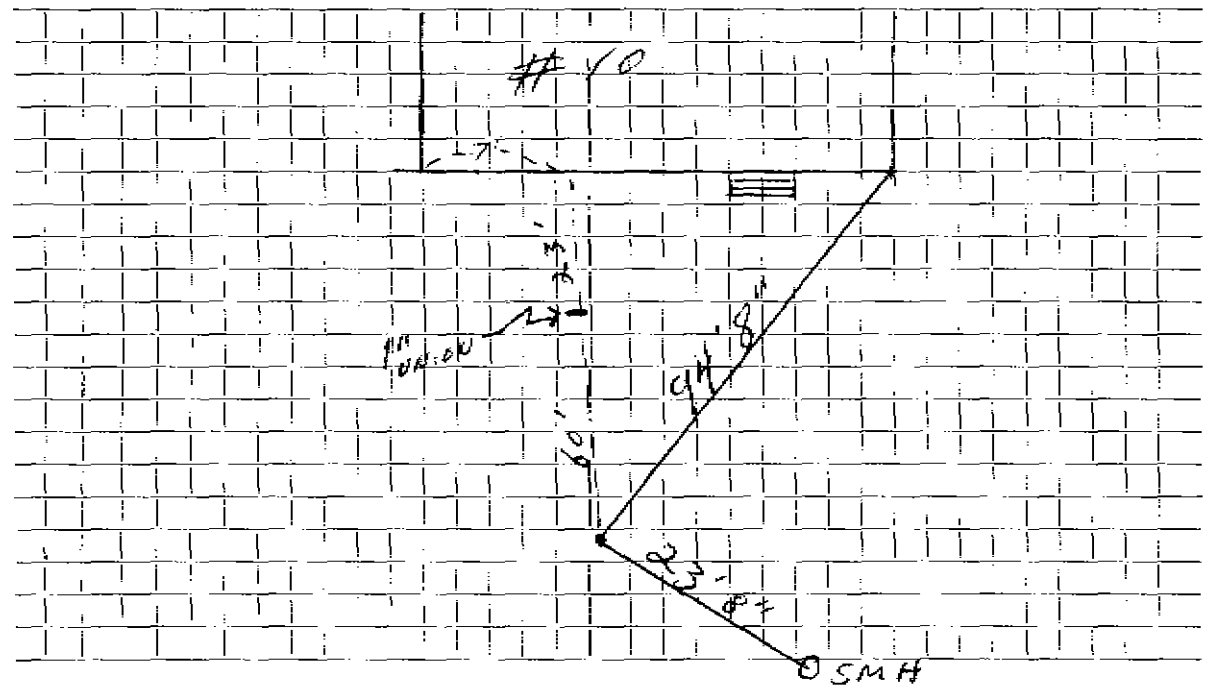

Connection made in Street. Work completed

Remarks:
.....
.....