

WATER SERVICE RECORD

Name Fleming Fox

Service No.

Address 12 GLEN RD.

Location

Repair ~~Renewal~~ New Service


ARLEX #0109

Date	Material	Amount	Total	Date	Amount
4/22/91	26 LF 3/4" COPPER			4-17-80	
				13' 3/4" Copper	
				1 3/4" C. X 3/4" C. To Iron	
				1 3/4" Curb Cock	
				1 1" L.h. Coupling	
				1 1" X 6" Cement lined nipple	
				1 1" Style 88	

DATE 4/22/91

TOWN OF LEXINGTON — BOARD OF PUBLIC WORKS  
WATER DIVISION

Sketch of Service Here

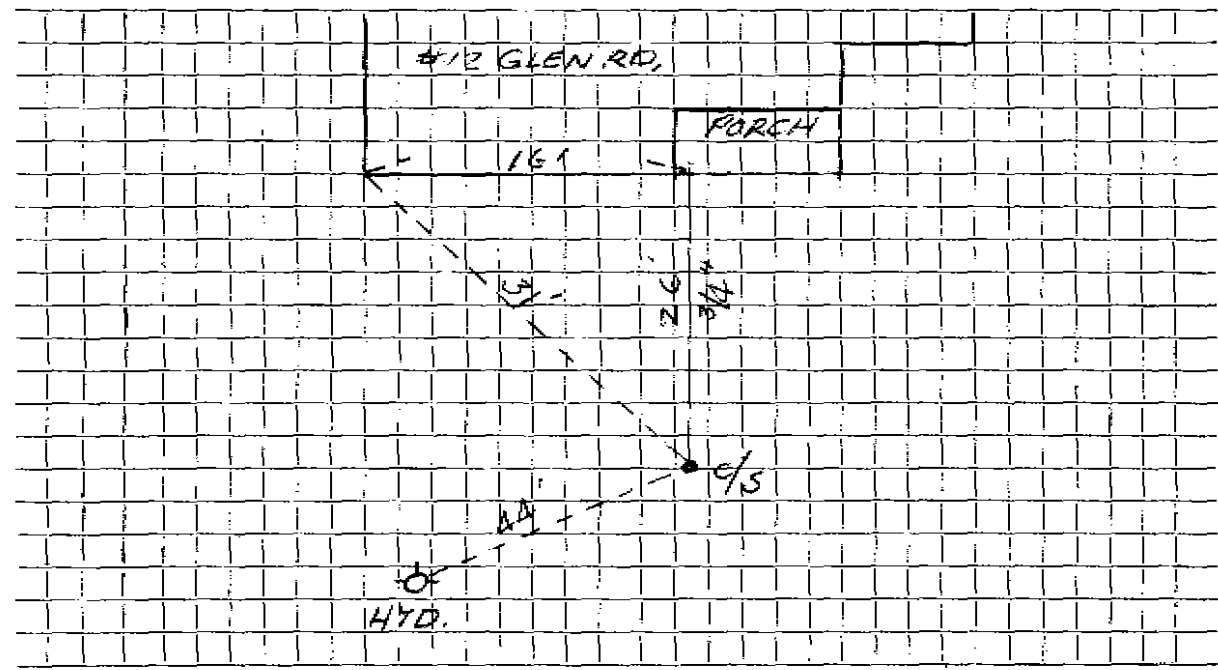

Connection made in GLEN RD. Street. Work completed 4/22/91

Remarks: RE-MOVED OLD LEAD SERV., INSTALL 3/4" COPPER  
CONTRACTOR: ABLEX