

## WATER SERVICE RECORD

Name John E. Wallace

Service No. 26

Address 8 Glen Road

Location

~~Repair~~ ~~Renewal~~ ~~New Service~~ W. O. # 8104

JAN 17 1972


Date	Material	Amount	Total	Date	Amount
9/20/71	Labor	63 76		9-8-71	Deposit 125 00
9/21/71	"	15 94	79 70	1-17-72	Retrad 31 02
	10% O.H.		7 97		153 98
	42' -3/4" Copper pipe .79		33 18		
1	3/4" Wheel Valve		12 53		OUTSIDE
1	Yd. Loam		3 50	9/20/71	Labor 63 76
1	Lb. Seed		1 10	11/3/71	" 19 83
2	Hrs. shovel 6.50		13 00	9'	3/4" Copper pipe .79 7 11
1	Hr. trucking		3 00	1	3/4" Corporation 9 57
			153 98	1/2	Ton cold patch 8.00 2 00
				1	" hot top 2 49
				3	Hrs. trucking 3.00 9 00
				1	" shovel 4 00
				1/2	" roller 2.00 1 00
					trailer 2 00
					125 72

DATE \_\_\_\_\_

TOWN OF LEXINGTON — BOARD OF PUBLIC WORKS

**WATER DIVISION**

Sketch of Service Here

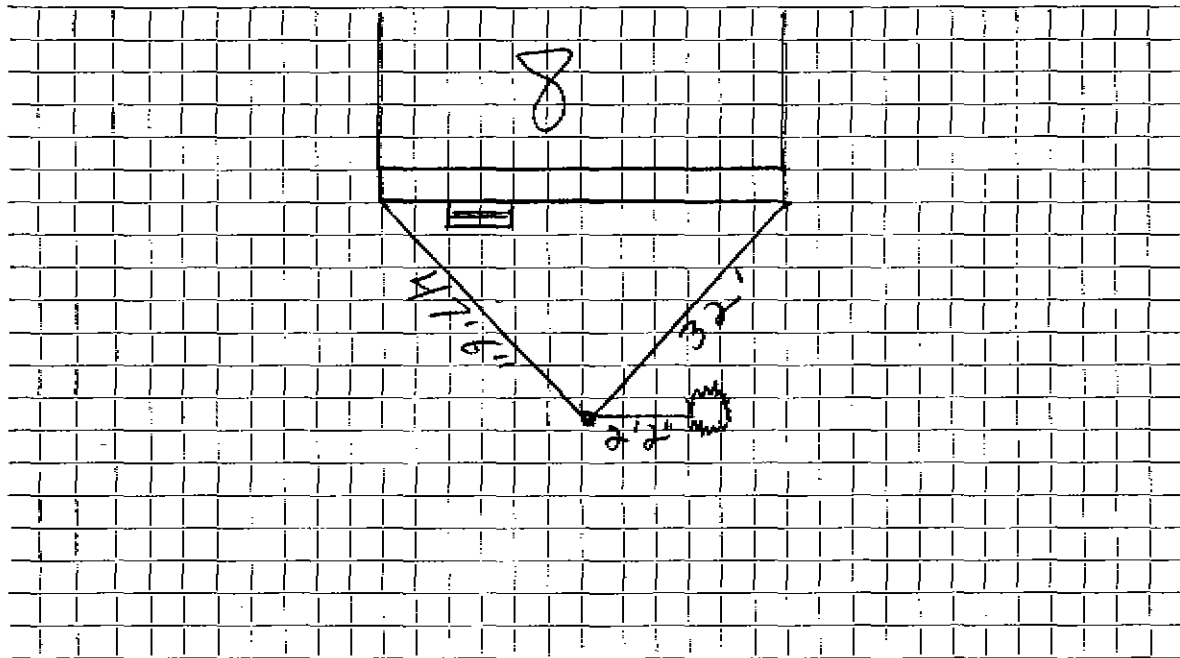

Connection made in ..... Street. Work completed .....

Remarks: .....

.....

.....