

WATER SERVICE RECORD

Name Clifford L. Muzzey

Service No. 106

Address ~~14 GLEN ROAD SOUTH~~ 14 Glen Road South (3/16/66)

Location

Repair—Renewal—~~NEW SERVICE~~

Date	Material	Amount	Total	Date	Amount
6/23/58	Labor	84 38		6-6-58	300 00
6/27/58	"	80 26			
6/28/58	"	52 01		11-28-58	150 21
	10% overhead	19 67	216 32		450 21
	334'-1" copper tubing @.5202	173 75			NON CHARGE
	1-1" Cx3/4" I.W.H. stop & waste	6 59	6/24/58	Labor	18 08
	5-1" C-3 part unions @ 3.76	18 80	28-1"	copper tubing @.5202	14 57
	5 hrs. Town Shovel @ 6.50	32 50	1-1" C	corp cock	7 06
	3 hrs. trucking @.75	2 25	1-1" C	curb cock	7 64
		450 21	1 box & rod		5 00
			1-3/4" straight tail piece		50
			1-3/4" offset tail piece		50
			1 hr. town shovel @ 6.50		6 50
			2 hr. trucking @.75		1 50
			43' patch		43 00
					104 35

Bill sent 11-19-58


150 21

DATE _____

TOWN OF LEXINGTON — BOARD OF PUBLIC WORKS

WATER DIVISION

Sketch of Service Here

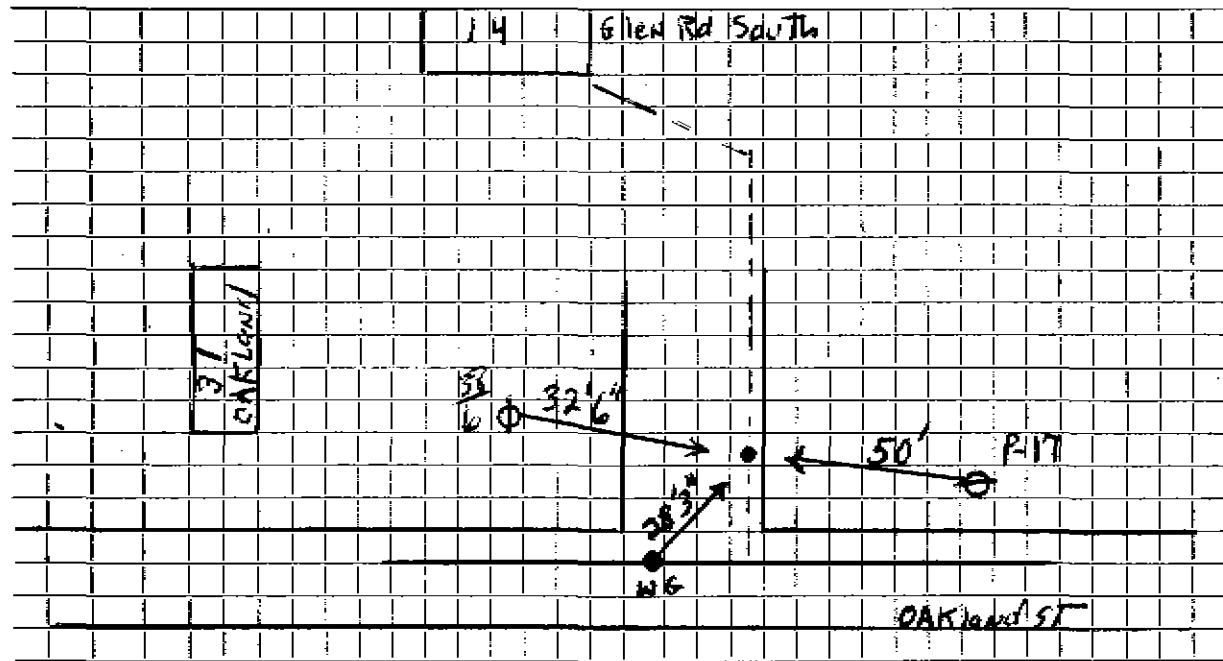

Connection made in _____ Street. Work completed _____

Remarks: _____

