

Name Charles F. Marshall

Service No. 267

Address 43 Golden Avenue

3114

Lexington, Mass.

Location 43 Golden Avenue

Kind of Pipe

Size

Size of Main

~~Repair-Renewal~~ New Service

Com. 11-6-50

Location

Date	Material	Amount	Total	Date	Amount	
9-14-50	Labor	6 00	6 00	Aug 27 50	42 72	
	10% Overhead		60		1 00	
	42' - 3/4" Copper Tubing @.275	11 55	11 55		43 60	
	1 - 3/4" C x 1/2" I.W.H. S&W	3 76	3 76	9-14-50	Labor	10 00
	Littlefield Shovel 2 hrs. @7.00	14 00	14 00	21' - 3/4" Copper Tubing @.275	5 78	
	Trucking 1 hr. @.75	75	75	1 - 3/4" C Corp-cock	3 60	
	Patching 7 x 3	7 00	7 00	1 - 3/4" C x 3/4" C Curb-cock	4 40	
			43 66	1 - Box & Rod	3 35	
				1 - 1/2" Offset Tail Piece	42	
				1 - 1/2" Straight Tail Piece	42	
				Littlefield Shovel 2 hrs. @7.00	14 00	
				Trucking 1 hr. @.75	75	
	Labor				42 72	

Hadley Press, Inc., Lexington

## TOWN OF LEXINGTON—BOARD OF PUBLIC WORKS

### WATER DIVISION

The undersigned applies for a supply of water at No. \_\_\_\_\_ St. and hereby agrees to comply with the rules and regulations as now, or at any future time, established by the Board of Selectmen.

Am't. of Estimate \$ \_\_\_\_\_


Owner \_\_\_\_\_

Am't. Paid \$ \_\_\_\_\_

Address \_\_\_\_\_

Builder \_\_\_\_\_

Sketch of Service Here

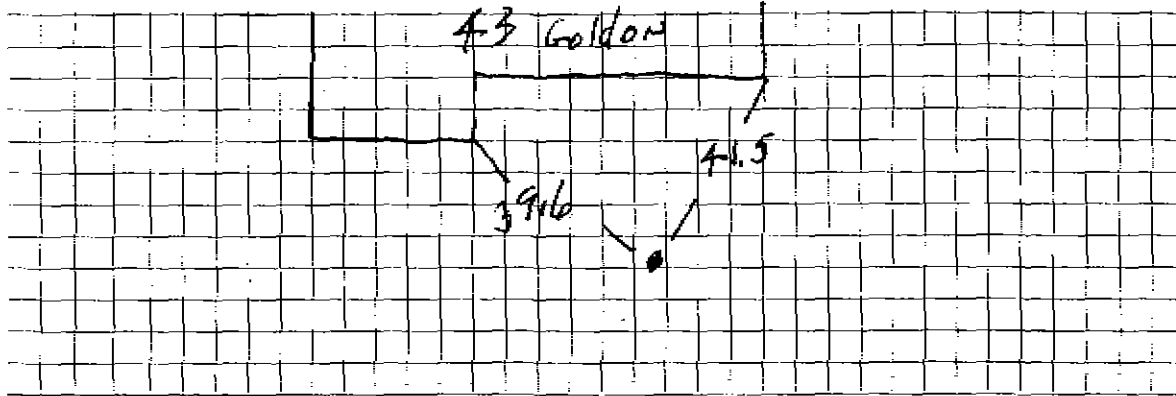

Connection made in \_\_\_\_\_ Street.

Work completed \_\_\_\_\_ 19\_\_

Remarks: