

Name Arthur W. Williams

Service No. 263

Address 44 Golden Avenue

Lexington, Mass.

Locatic 44 Golden Avenue

Kind of Pipe

Size

Size of Main

~~Repair - Renewal~~ New Service

Com. 11-6-50

Location

Date	Material	Amount	Total	Date	Amount
Sept. 14, '50	Labor	10 00	10 00	<i>Sept 27 '50</i>	<i>20 00</i>
	10% Overhead		1 00	<i>10 00</i>	<i>1 00</i>
	34' - 3/4" Copper Tubing @.275		9 35		No Charge
	1 - 3/4"C x 1/2" I.W.H. S&W		3 76	Sept. 14, '50	Labor
	Littlefield Shovel 4 hrs. @7.00	28 00			13 12
	Trucking 1 hr. @.75		75		14' - 3/4" Copper Tubing @.275
	Patching 12 x 3		12 00		3 85
			64 86		1 - 3/4"C Corp-cock
					3 60
					1 - 3/4"C x 3/4"C Curb-cock
					4 40
					1 - Box & Rod
					3 35
					1 - 1/2" Offset Tail Piece
					42
					1 - 1/2" Straight Tail Piece
					42
					Littlefield Shovel 2 hrs. @7.00
					14 00
					Trucking 1 hr. @.75
					75
	Labor				<u>43 91</u>

DATE \_\_\_\_\_

# TOWN OF LEXINGTON—BOARD OF PUBLIC WORKS WATER DIVISION

The undersigned applies for a supply of water at No. \_\_\_\_\_ St. and hereby agrees to comply with the rules and regulations as now, or at any future time, established by the Board of Selectmen.

Am't. of Estimate \$ \_\_\_\_\_


Owner \_\_\_\_\_

Am't. Paid \$ \_\_\_\_\_

Address \_\_\_\_\_

Builder \_\_\_\_\_

Sketch of Service Here

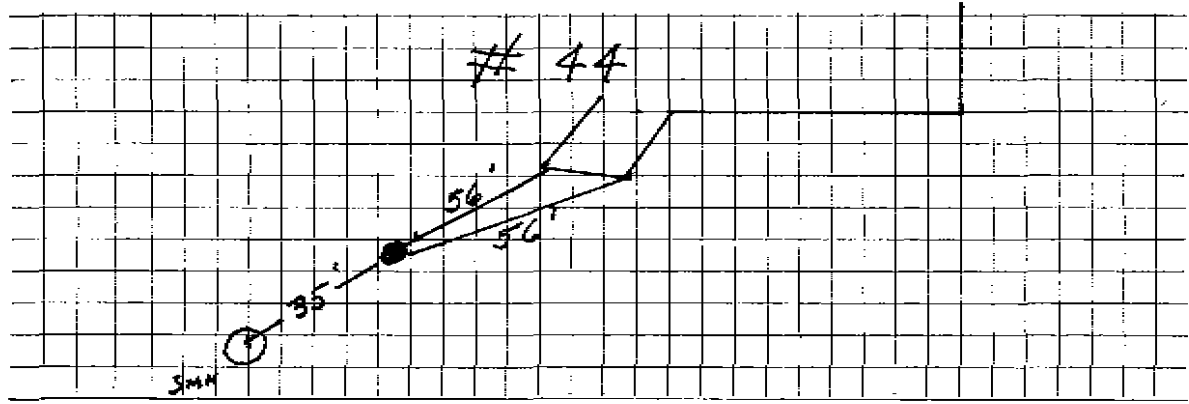

Connection made in \_\_\_\_\_ Street.

Work completed \_\_\_\_\_ 19

Remarks: