

WATER SERVICE RECORD

Name Marcus A. Marcussen

Service No. 108

Address 46 Golden Avenue

Location Lexington

~~Repair - Extension~~ New Service

Com 7-28-52


Date	Material	Amount	Total	Date	Amount
6/19/52	Labor	12 08			
	10% Overhead	1 21	13 29		
	60' - 3/4" Copper tubing @ .3439	20 63			
	1 - 3/4" C x 1/2" I.W.H. Stop & Waste	4 00			
	4 hrs. Littlefield Shovel		28 00		
	1 hr. trucking		75		
	patching 4 X 3		4 00		
			70 67		
				6-9-52	
				7-28-52	
				Deposited	
				NON CHARGE	
				7/3/52	
				Labor	26 46
				8' - 3/4" Copper tubing @ .3439	2 75
				1 - 3/4" C. Corp-cock	4 33
				1 - 3/4" C x 3/4" C. Curb-cock	4 67
				1 Box and Rod	4 52
				1 - 1/2" offset tail piece	50
				1 - 1/2" straight tail piece	50
				2 hrs. Littlefield Shovel	14 00
				1 hr. trucking	75
					58 44

DATE _____

TOWN OF LEXINGTON — BOARD OF PUBLIC WORKS

WATER DIVISION

Sketch of Service Here

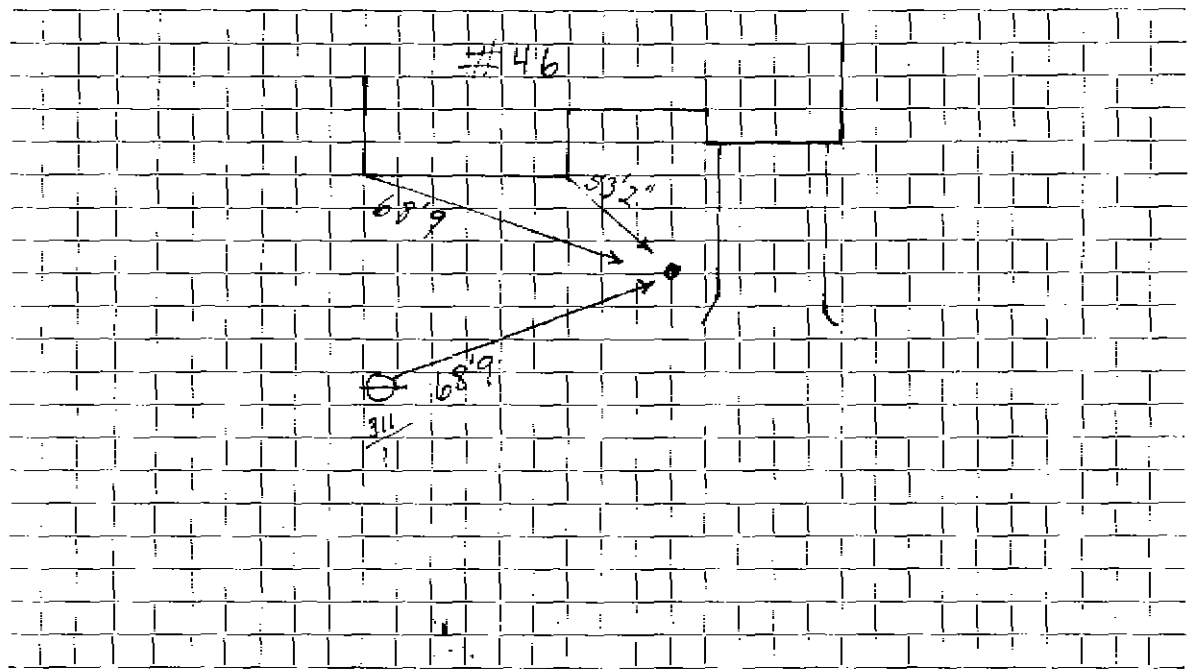

Connection made in Street: Work completed

Remarks:
.....
.....