

WATER SERVICE RECORD

#4171

Name Gordon E. Cunningham

Service No. 353

Address 47 Golden Avenue

Location Lexington, Mass.

Repair ~~Renewal~~ - New Service

Com. 2-19-51


| Date | Material | Amount | Total | Date | Amount |
|--------|---------------------------------|--------|-------|---------|----------------------------------|
| 1-4-51 | Labor | 9 30 | 9 30 | 7-15-51 | 75 00 |
| | 20% Overhead | | 93 | | 1 00 |
| | 40' - 3/4" Copper Tubing @.34 | 13 60 | | | No Charge |
| | 1 - 3/4" C x 1/2" I.W.E. S&W | 4 00 | | 1-5-51 | Labor |
| | Littlefield Shovel 4 hrs. @7.00 | 28 00 | | | 7 30 |
| | Trucking 1 hr. @.75 | | 75 | | 32' - 3/4" Copper Tubing @.34 |
| | | | 56 58 | | 10 88 |
| | | | | | 1 - 3/4" C Corp-cock |
| | | | | | 4 33 |
| | | | | | 1 - 3/4" C x 3/4" C Curb-cock |
| | | | | | 4 67 |
| | | | | | 1 - 3/4" C x 3/4" C Union (3pts) |
| | | | | | 1 72 |
| | | | | | 1 - Box & Rod |
| | | | | | 3 90 |
| | | | | | 1 - 1/2" Offset Tail Piece |
| | | | | | 50 |
| | | | | | 1 - 1/2" Straight Tail Piece |
| | | | | | 50 |
| | | | | | Littlefield Shovel 4 hrs. @7.00 |
| | | | | | 28 00 |
| | | | | | Trucking 1 hr. @.75 |
| | | | | | 75 |
| | | | | | 62 55 |

DATE _____

TOWN OF LEXINGTON — BOARD OF PUBLIC WORKS

WATER DIVISION

Sketch of Service Here

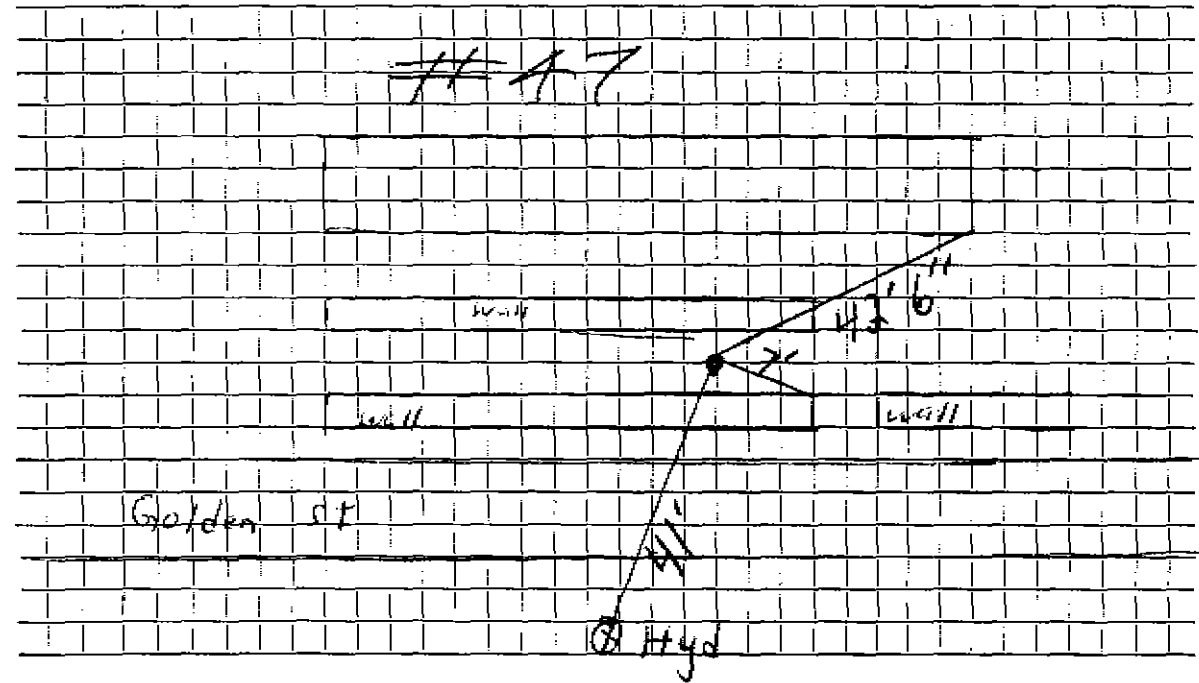

Connection made in Street. Work completed

Remarks:
.....
.....