

Name Mr. Francis MacNeil
 Address 30 Moraine St., Waverley

Service No. ~~85~~ 1045
 2623

Location #17 *Goodwin Road*

Kind of Pipe Size Size of Main

~~Repairs-General~~ - New Service

Location

Date	Material	Amount	Total	Date	Amount
Comm 34.26	55 $\frac{1}{2}$ " Copper Pipe @ .15	8 25			
12-31-32	1 $\frac{3}{4}$ " " Bend	60			
	1 S & W	2 75			
	Trucking	75	12 35		
12/17/32	7 Hrs. Labor @ .55	3 85			
	3 " " @ .60	1 80	5 65		
	15% Overhead		85		
	<u>COST</u>		<u>18 85</u>		
	55 @ .60, \$33.00				
	<u>ESTIMATED COST</u>	<u>\$34 20</u>	<u>\$34 20</u>		
	Labor				

Nov. 21 1932 - Cash 34 20

Hadley Press, Inc., Lexington

DATE November 9, 1932

TOWN OF LEXINGTON—BOARD OF PUBLIC WORKS

WATER DIVISION

The undersigned applies for a supply of water at No. Lot 5, Goodwin Road St. and hereby agrees to comply with the rules and regulations as now, or at any future time, established by the Board of Selectmen.

Am't. of Estimate \$ _____


Owner Franci Mae Hill

Am't. Paid \$ _____

Address #130 Moraine St
Waverly

Builder _____

Sketch of Service Here

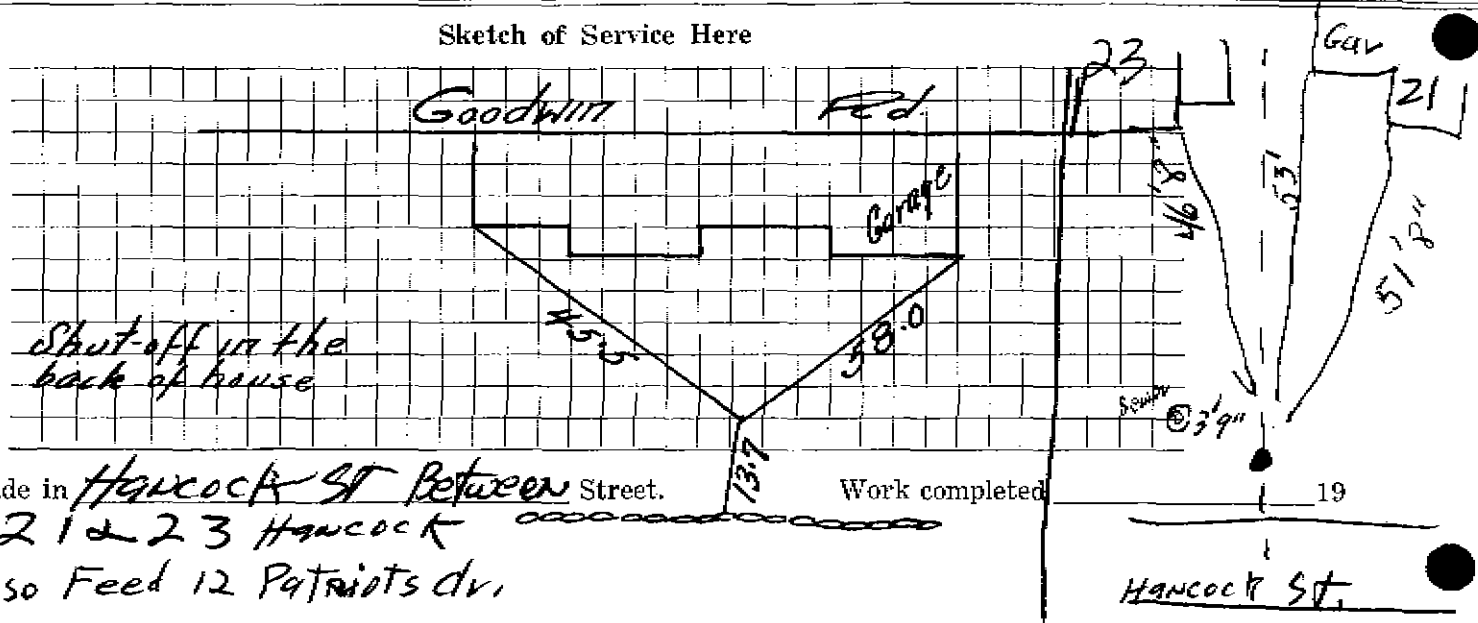

Connection made in Hancock St Between Street.

Remarks: 21 & 23 Hancock
also Feed 12 Patriots dr.

Work completed

Hancock St.