


TOWN OF LEXINGTON — BOARD OF PUBLIC WORKS

WATER DIVISION

Sketch of Service Here

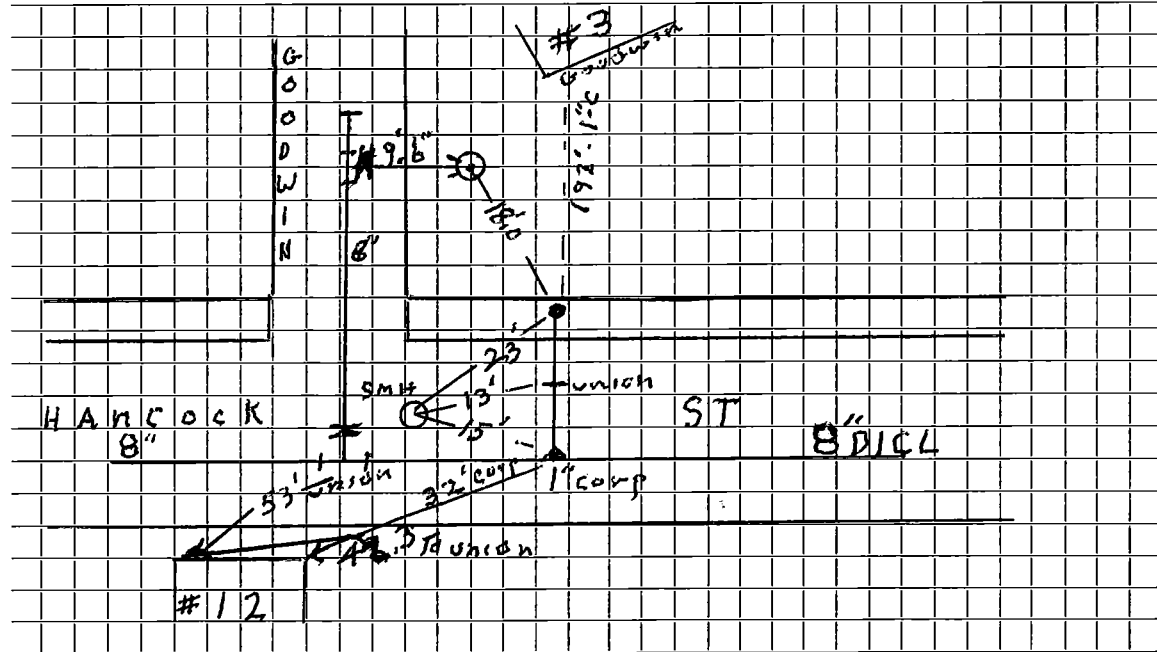

Connection made in Hancock St Street. Work completed 7/26/12 Dr. Felice

Remarks: 1" copper connected to exist. 1" copper in St. Exist. curb left in place

.....
.....