


TOWN OF LEXINGTON — BOARD OF PUBLIC WORKS

WATER DIVISION

Sketch of Service Here

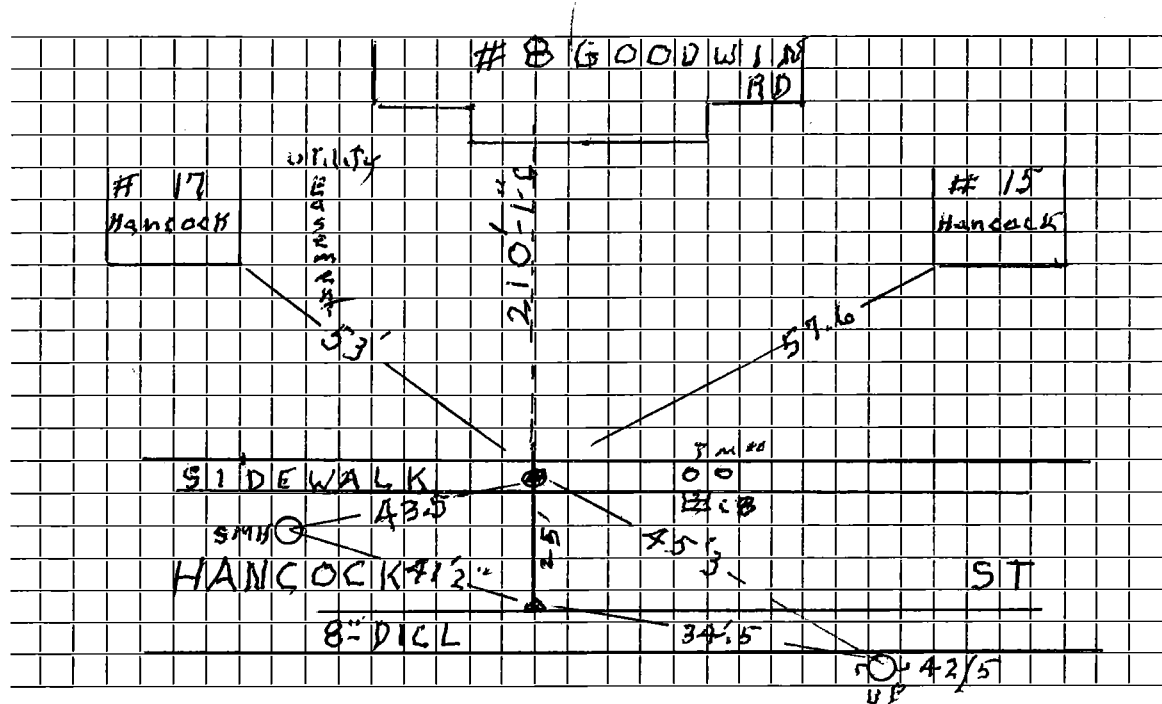

Connection made in Street. Work completed ... 7-30-12 - Def. 11-11-12 ...
 Remarks: 1" Service Tap ON NEW 8" DI CL / House Ties from old T & C rd