

Name Enico Anastasy
 Address 2 Gould Road
187 Grove Street (5-20-98)

Service No.

3644

Lexington, Mass.

Location 187 Grove Street

Kind of Pipe

Size

Size of Main

~~Repair~~ ~~Renewal~~ ~~New Service~~

Location

Date	Material	Amount	Total	Date	Amount
Sept. 14, '48	Labor	15 10	15 10	Sept. 14, '48	100 00
	10' Overhaul		1 71	Sept. 14, '48	
	100' - 1" Copper Tubing 0.31	32 24	32 24	Sept. 14, '48	82 82
	1 - 1" C x 3/4" I.P.S. 20'	3 15	3 15	Sept. 14, '48	7 10
	1 - 1" C x 1" C elbows (2) 20'	1 71	1 71	Sept. 14, '48	10 23
	Littlefield Shovel 1 hr. 75	21 00	21 00	Sept. 14, '48	3 06
	Trucking 1 hr. 75	75	75	Sept. 14, '48	4 30
			82 82	Sept. 14, '48	3 45
				Sept. 14, '48	7 00
				Sept. 14, '48	30
				Sept. 14, '48	30
				Sept. 14, '48	75
				Sept. 14, '48	38 29
	Labor				

Com. 10/25/48

Deposited
 100 00
 17 17
 82 82

DATE _____

TOWN OF LEXINGTON - BOARD OF PUBLIC WORKS

WATER DIVISION

The undersigned applies for a supply of water at No..... St. and hereby agrees to comply with the rules and regulations as now, or at any future time, established by the Board of Selectmen.

Am't of Estimate \$.....

Owner


Am't Paid \$.....

Address

Builder

.....

Sketch of Service Here

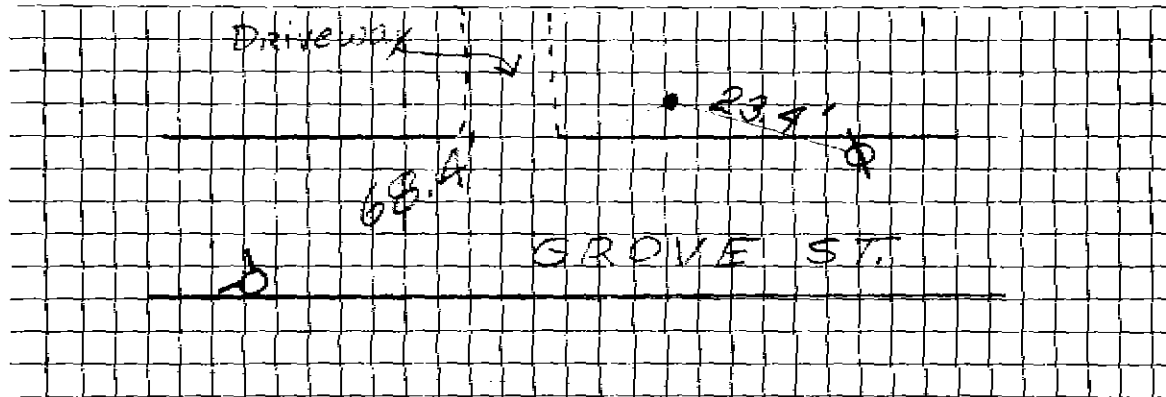

Connection made in Street.

Work completed19

Remarks: