

WATER SERVICE RECORD

Name Benjamin Franklin Homes

Service No. 168

Address Lot 22 Gould Road

House #7

Location

~~Repair - New Service~~ New Service


Comm. 11-18-57

Date	Material	Amount	Total	Date	Amount
8/15/57	Labor	20 94		8-7-57	Deposit \$ 75 00
	10% overhead	2 09	23 03	11-18-57	Refund \$ 22 88
	45' - 3/4" Copper tubing @ .375	16 88			\$ 52 12
	1 - 3/4" Cx 1/2 I.W.H. Stop & Waste	4 96			<u>NON CHARGE</u>
	1 hr. Town Shovel		6 50	12/19/56	Labor 3 38
	1 hr. Trucking		75	25' 3/4" Copper tubing @ .4396	10 99
			52 12	1 3/4" C Corp Cock	4 64
				1 3/4" C Curb Cock	5 94
				1 Box & Rod	4 62
					<u>29 57</u>
				1 - 1/2 Straight tailpiece	50
				1 - 1/2 Offset tailpiece	50
					<u>30 57</u>
				\$ \$ 11.36 applied to w.H.O.	
				#361 1957	

TOWN OF LEXINGTON — BOARD OF PUBLIC WORKS
DATE _____

WATER DIVISION

Sketch of Service Here

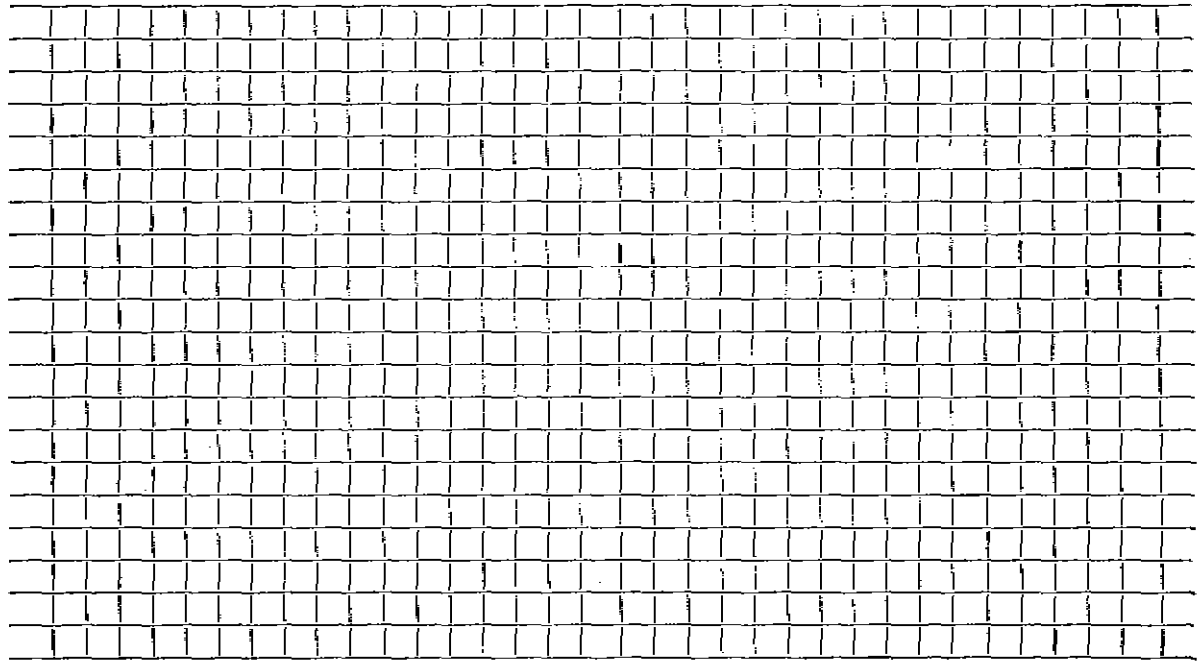

Connection made in _____ Street. Work completed _____
Remarks: _____