

WATER SERVICE RECORD

Name Lexland Construction

Service No. 80

Address House #4
Lot 19 Gould Road

Location

~~RENEWAL~~ New Service

Comm 11-17-58


Date	Material	Amount	Total	Date	Amount	
5-27-58	Labor	8.25		5-12-58	Deposit	50.00
	10% O.H.	.83	9.08	11-7-58	Paid by W.P.C. # 81	12.34
	120' 3/4" Copper tubing @.37		44.40			62.34
	1 3/4" C x 1/2" I.W.H. Stop & Waste	5.84			NON CHARGE	
	1 3/4" C 3 part union	2.27	12/19/56	Labor	3.38	
	1 hr. Trucking @.75	.75	35' 3/4" Copper tubing @.4396		15.39	
		62.34	2 3/4 Unions 3 part		4.54	
			1 3/4" C Corp Cock		4.64	
			1 3/4" C Curb Cock		5.94	
			1 Box & Rod		4.62	
					38.51	
				1 1/2 Straight tailpiece	.50	
				1 1/2 Offset tailpiece	.50	
					39.51	

DATE _____

TOWN OF LEXINGTON — BOARD OF PUBLIC WORKS

WATER DIVISION

Sketch of Service Here

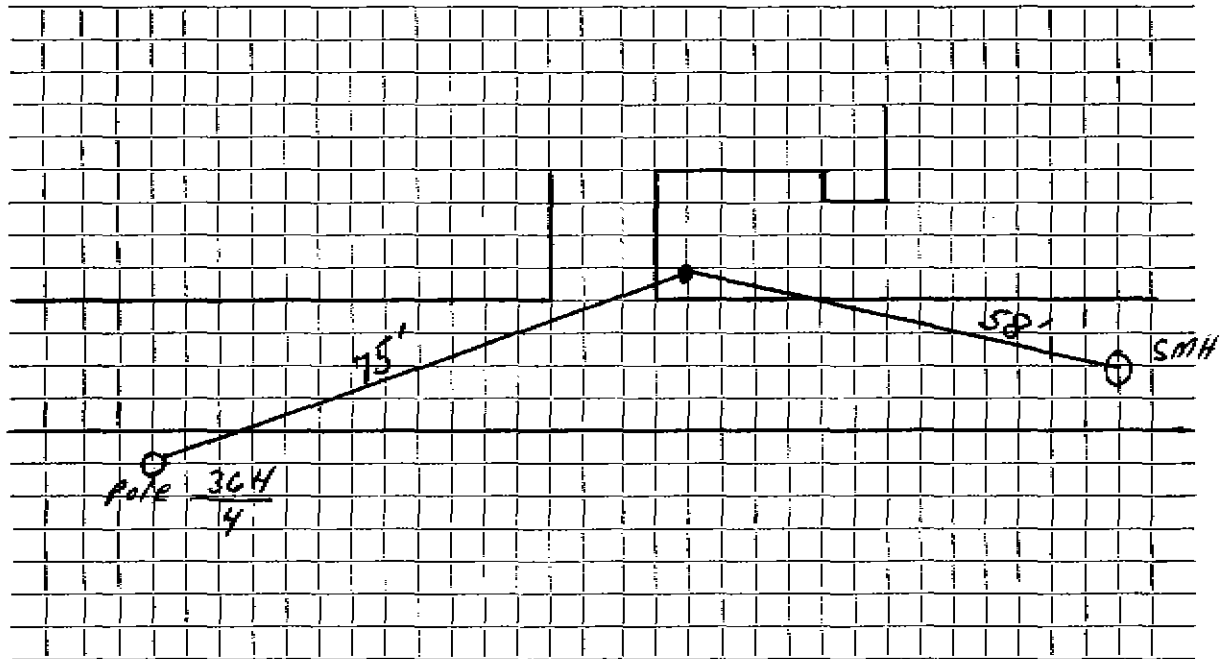

Connection made in Street. Work completed

Remarks:
.....
.....