

WATER SERVICE RECORD

Name Lexland Construction

Service No. 156

Address 8 Gould Road

#5728  
#7632

Location

Repair ~~Renewal~~ — New Service

Comm 12-1-58


Date	Material	Amount	Total	Date	Amount
7/28/58	Labor	8 60		7-28-58	Deposit 50 00
7/29/58	"	5 16		12-1-58	paid by W. H. C. 188 #187 #127 <sup>Refund</sup> 42 14
			13 76		92 14
	10% overhead		1 38		
	176' 3/4" copper tubing @ .37	65 12			NON CHARGE
	1 3/4" Cx 1/2 IWH stop & waste	5 84			1 1/2 straight tail pc. 50
	2 3/4" C 3 part union @ 2.27	4 54			1 1/2 offset tail pc. 50
	2 hrs. trucking @ .75	1 50			
			92 14		
	Service off Dewey rd.				

DATE 9/16/94

TOWN OF LEXINGTON — BOARD OF PUBLIC WORKS

WATER DIVISION

Sketch of Service Here

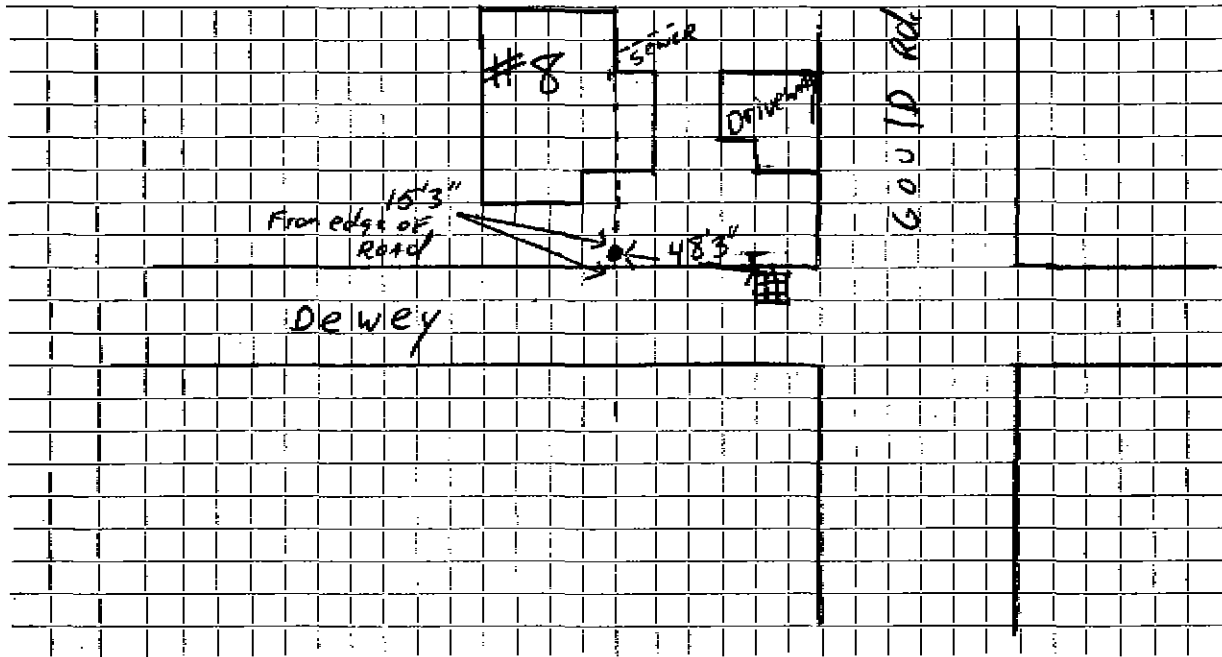

Connection made in ..... Street. Work completed .....

Remarks: .....  
.....  
.....