

Name Parker Hallett

Service No. 17

Address 11 Grandview Avenue

3391

Lexington, Mass.

Location 11 Grandview Avenue

Kind of Pipe

Size

Size of Main

~~Repair~~ ~~Renewal~~ ~~New Service~~

Com. 9-26-49

Location

Date	Material	Amount	Total	Date	Amount
Aug. 16, '49	Labor	4 27	4 27	Aug 18 '49	35 00
	10% Overhead		43		
	38' - 3/4" Copper Tubing @ .24	9 12	9 12		28 86
	1 - 3/4" C x 1/2" I.W.H. S&W	3 29	3 29	Aug. 16, '49 Labor	4 00
	Littlefield Shovel 1 1/2 hrs. @ 7.00	10 50	10 50	7' - 3/4" Copper Tubing @ .24	1 68
	Trucking 1 hr. @ .75	75	75	1 - 3/4" C Corp-cock	3 15
			28 36	1 - 3/4" C x 3/4" C Curb-cock	3 85
				1 - Box & Rod	3 75
				1 - 1/2" Straight Tail Piece	37
				1 - 1/2" Offset Tail Piece	37
				Littlefield Shovel 1 hr. @ 7.00	7 00
				Trucking 1 hr. @ .75	75
	Labor				24 92

Reported

No Charge

TOWN OF LEXINGTON - BOARD OF PUBLIC WORKS

WATER DIVISION

The undersigned applies for a supply of water at No..... St. and hereby agrees to comply with the rules and regulations as now, or at any future time, established by the Board of Selectmen.

Am't of Estimate \$.....

Owner


Am't Paid \$.....

Address

Builder

.....

Sketch of Service Here

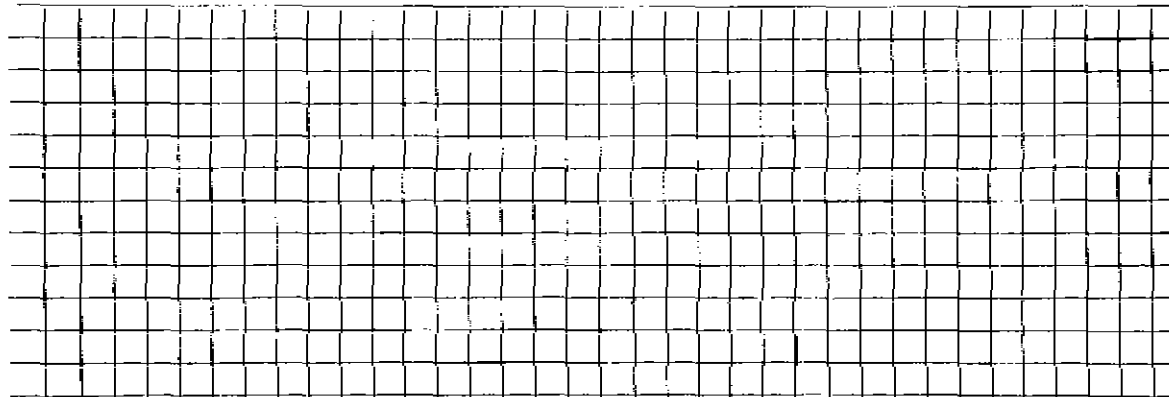

Connection made in Street.

Work completed19

Remarks: