


DATE 10 SEPT. 1996

TOWN OF LEXINGTON — BOARD OF PUBLIC WORKS
WATER DIVISION

Sketch of Service Here

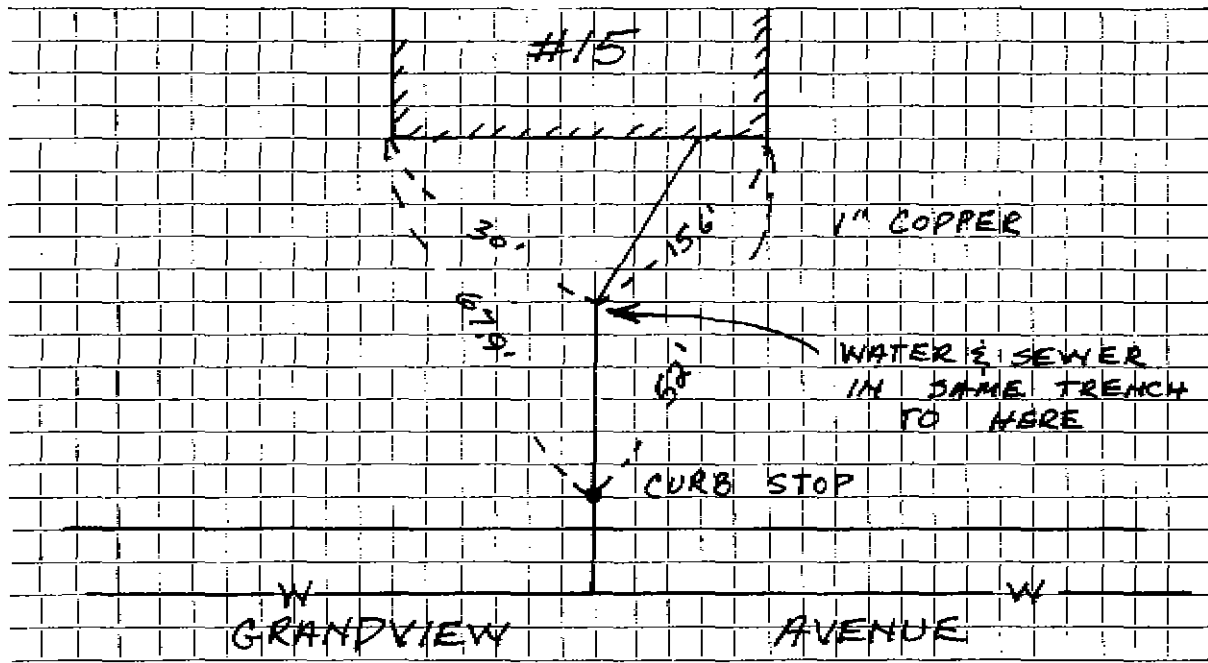

Connection made in GRANDVIEW AVENUE Street.

Work completed ARLEX OIL COMPANY

Remarks:


~~BOOK 916-14~~

DATE _____

TOWN OF LEXINGTON — BOARD OF PUBLIC WORKS

WATER DIVISION

Sketch of Service Here

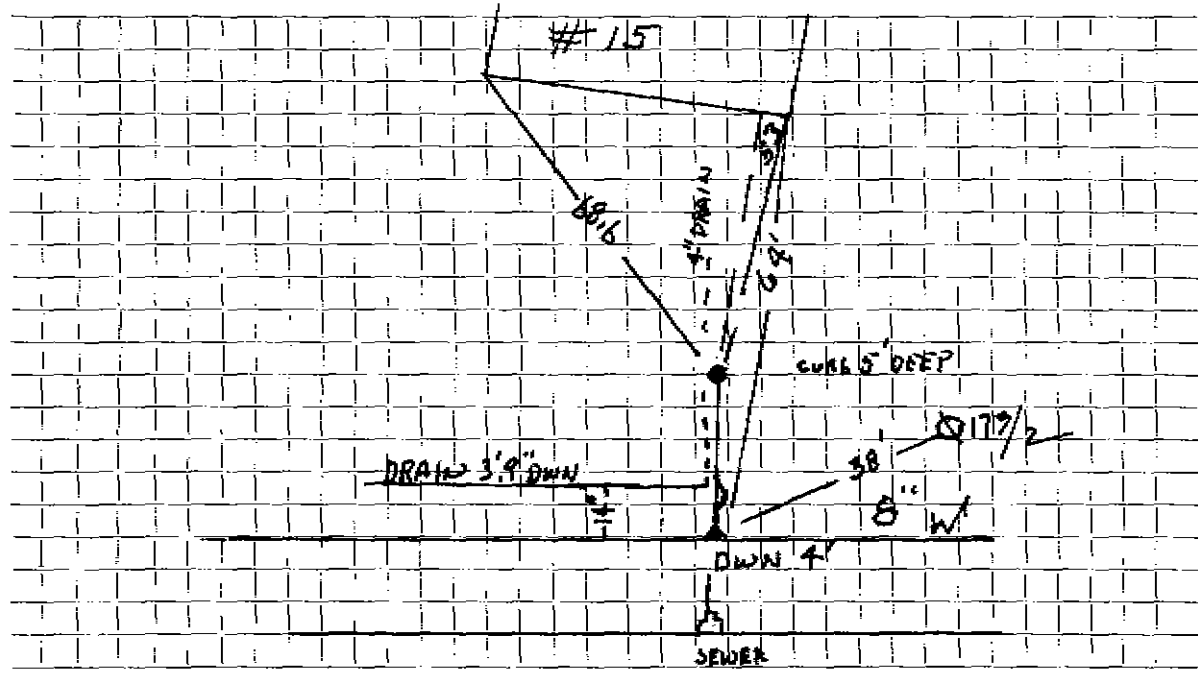

Connection made in _____ Street. Work completed 9/6/96

Remarks: 4" AT CORP GOES OVER DRAIN DWN 3' 9" w/INSULATION.
SEWER IS 8" UNDER W/MAIN