

WATER SERVICE RECORD

Name David G. Cameron

Service No. 122

Address 19 Grandview Ave

2293 - 2294

Location

~~Repair Charge~~ - New Service

Comm 8-22-60


Date	Material	Amount	Total	Date	Amount
7-26-60	Labor	1 94		7/5-60	Deposit 75 00
	10% O.H.	<u>19</u>	2 13	8-22-60	Retained 23 55
	97' 3/4" Copper tubing @42		40 74		51 45
	1 3/4" Cx 1/2 I.W.H. Stop&Waste		6 17		
	1 3/4" C3 part Union		<u>2 41</u>		NON CHARGE
			51 45	13' 3/4" Copper tubing @42	5 46
				1 3/4" C Corp Cock	4 91
				1 3/4" C Curb Cock	6 28
				1 Box & Rod	4 90
				1 1/2 Straight tailpiece	50
				1 1/2 Offset tailpiece	<u>50</u>
					22 55

DATE _____

TOWN OF LEXINGTON — BOARD OF PUBLIC WORKS

WATER DIVISION

Sketch of Service Here

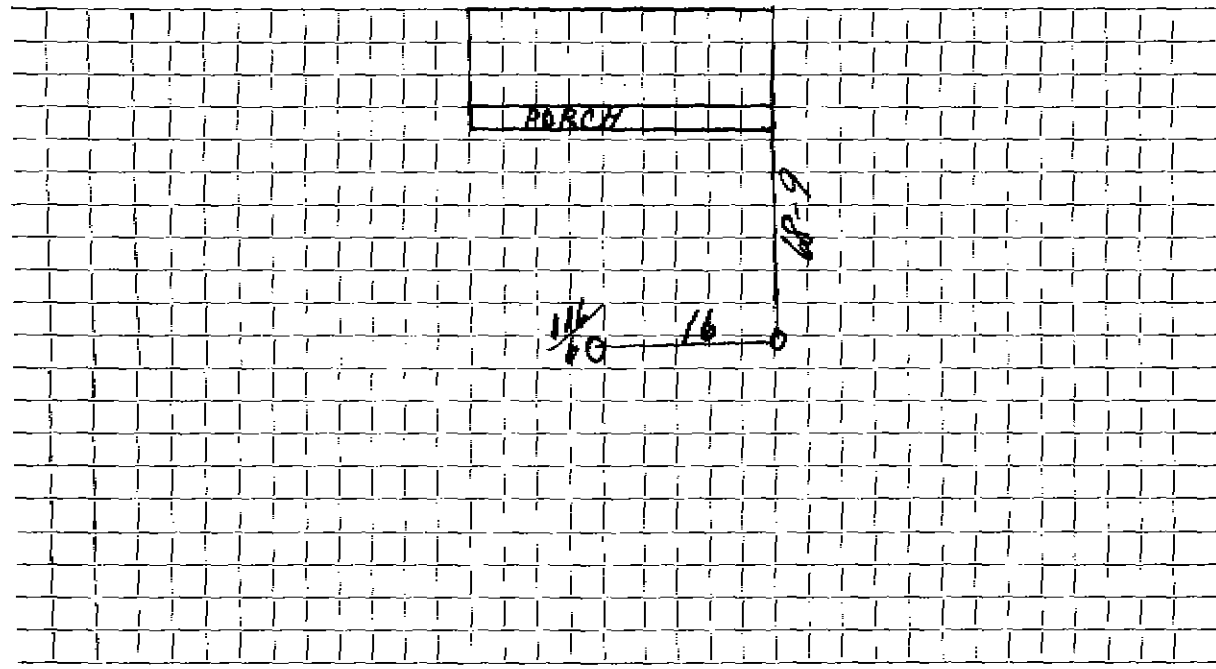

Connection made in Street. Work completed

Remarks:
.....
.....