

## WATER SERVICE RECORD

3001

Name Norman E. Newlands

Service No. 209

Address 49 Grandview Road

Location

~~Repairs - Remedy~~ - New Service


Comm 11-21-60

Date	Material	Amount	Total	Date	Amount	
10-10-60	Labor	38.50		9-28-60	Report	251.00
10-13-60	"	6.22	44.72	11-21-60	Retuned	136.43
	10% O.H.	4.47	49.19			113.57
	65' 3/4" Copper tubing @ .42		27.30		NON CHARGE	
1	3/4" C x 1/2 I.W.R. Stop & Waste		6.17	10-13-60	Labor	50.25
1	3/4" C 3 part union		2.41	10-14-60	"	23.10
5	hrs. Pippin Shovel @ 4.50		22.50		92' 3/4" Copper tubing @ .42	38.64
2	hrs. Trucking @ 3.00		6.00	5-22-90	1 3/4" C Corp Cock COMP	4.91
			113.57		2 3/4" C Curb Cocks @ 6.28	12.56
					<del>2 1 1/2" Style 38 Couplings @ 3.50</del>	<del>7.00</del>
					2 Box & Rods @ 4.90	9.80
					<del>2 2 1/2 x 6" C.L. Nipples @ 1.09</del>	<del>2.18</del>
					<del>1 1 1/2 Tee</del>	<del>2.48</del>
					1 3/4" C 3 part union	2.41
					5 hrs Pippin @ 4.50	22.50
					1 hr. Trucking @ 3.00	3.00
				5-22-90	1 3/4 Union Comp	178.83
					2' 3/4 COPPER	

TOWN OF LEXINGTON — BOARD OF PUBLIC WORKS

WATER DIVISION

Sketch of Service Here

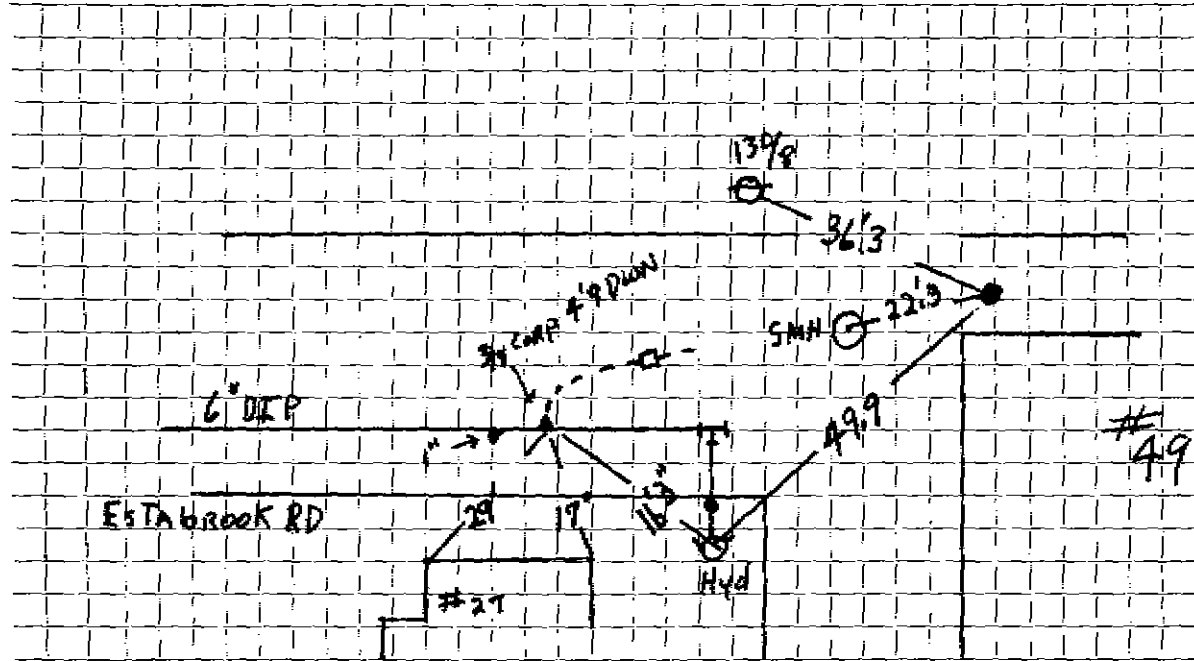

Connection made in Estabrook RD 6" DWP Street. Work completed .....

Remarks: 1' 6" BETWEEN CORPS .....

.....  
.....