

WATER SERVICE RECORD

Name Paula Realty Trust Co.

Service No. 146

Address 8 Grandview Avenue

940

Location

~~Repair Record~~ New Service WO #7681

Comm - 1-14-63


Date	Material	Amount	Total	Date	Amount	
10-30-62	Labor	1.78		10-23-62	Deposit	50.00
	10% O.H.	.18	1.96	1-14-63	Refund	10.00
70'	3/4" Copper tubing @.42		29.40			39.94
1	3/4" CX 1/2 I.W.H. Stop & Waste		6.17			
1	3/4" C3 Part Union		2.41		NON CHARGE	
			39.94	10-30-62	Labor	1.93
				21'	3/4" Copper tubinh @.42	8.82
				1	3/4" C Corp Cock	4.91
				1	3/4" C Curb Cock	6.28
				1	Box & Rod	4.90
				1	1/2 Straight Tailpiece	.50
				1	1/2 Offset Tailpiece	.50
						27.84

DATE _____

TOWN OF LEXINGTON — BOARD OF PUBLIC WORKS

WATER DIVISION

Sketch of Service Here

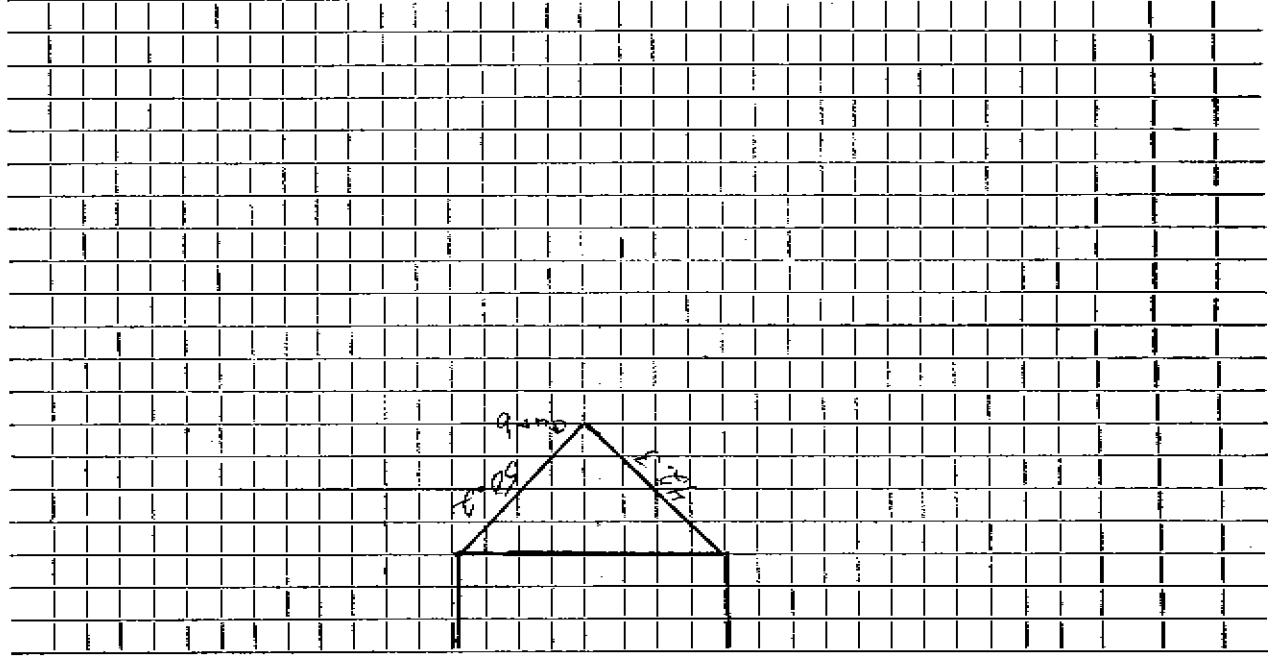

Connection made in _____ Street. Work completed _____

Remarks: _____