


DATE 2 NOVEMBER 1995

TOWN OF LEXINGTON — BOARD OF PUBLIC WORKS

WATER DIVISION

Sketch of Service Here

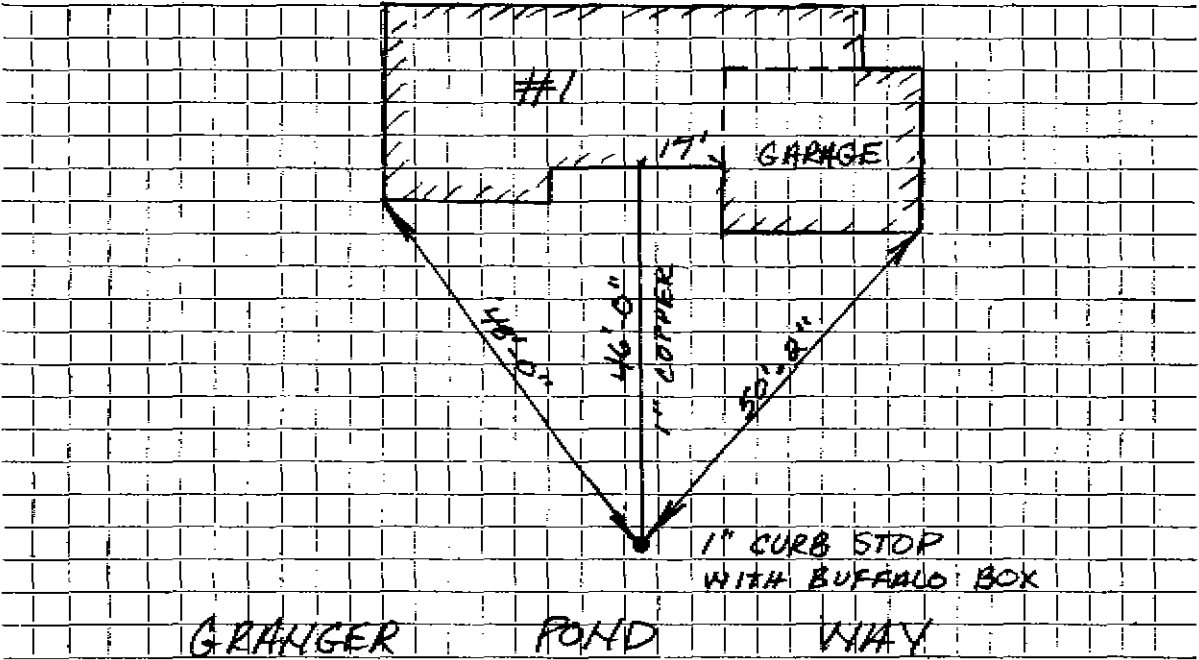

Connection made in GRANGER POND WAY Street.

Work completed J.M. McLaughlin, Inc.

Remarks: