




DATE 10 SEPT. 1995

TOWN OF LEXINGTON — BOARD OF PUBLIC WORKS  
WATER DIVISION

Sketch of Service Here

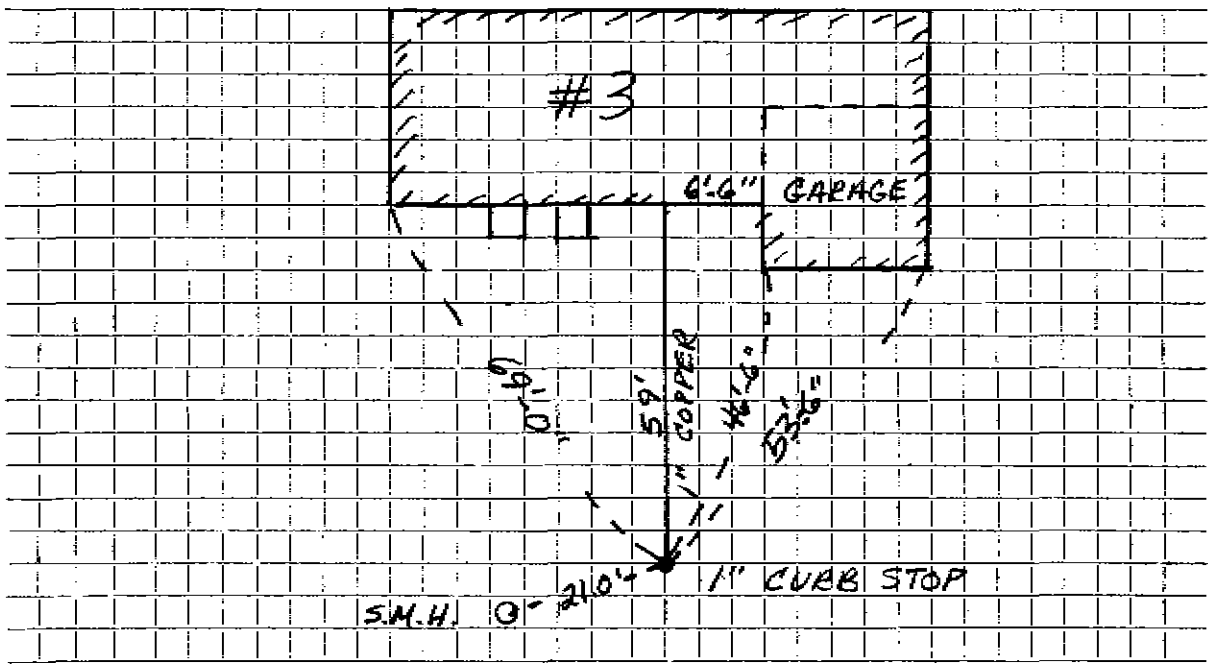

Connection made in GRANGER POND WAY Street.

Work completed J.M. McLaughlin

Remarks: