

WATER SERVICE RECORD

6077

Name

Service No.

Address

11 Grant Place

Location

Repair—Renewal—New Service

Date	Material	Amount	Total	Date	Amount
					<i>OUTSIDE</i>
				1984	22'
					Copper
					1" Corp
					Curb
					Box & Rod


3/4 Copper Supplied by Owner

DATE _____

TOWN OF LEXINGTON — BOARD OF PUBLIC WORKS

WATER DIVISION

Sketch of Service Here

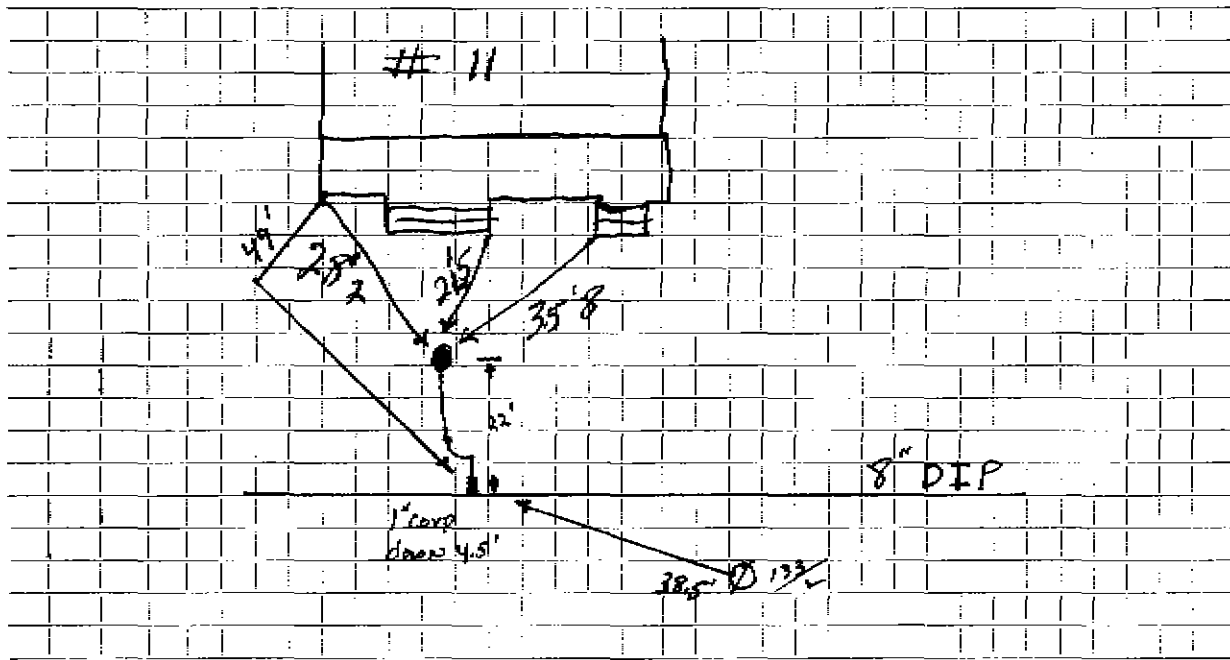

Connection made in _____ Street. Work completed 4-17-83 - outside Renewal

Remarks: Tap 1" - Copper 1" may be reduced to 3/4" Lee-Cons Co.