


DATE _____

TOWN OF LEXINGTON — BOARD OF PUBLIC WORKS

WATER DIVISION

Sketch of Service Here

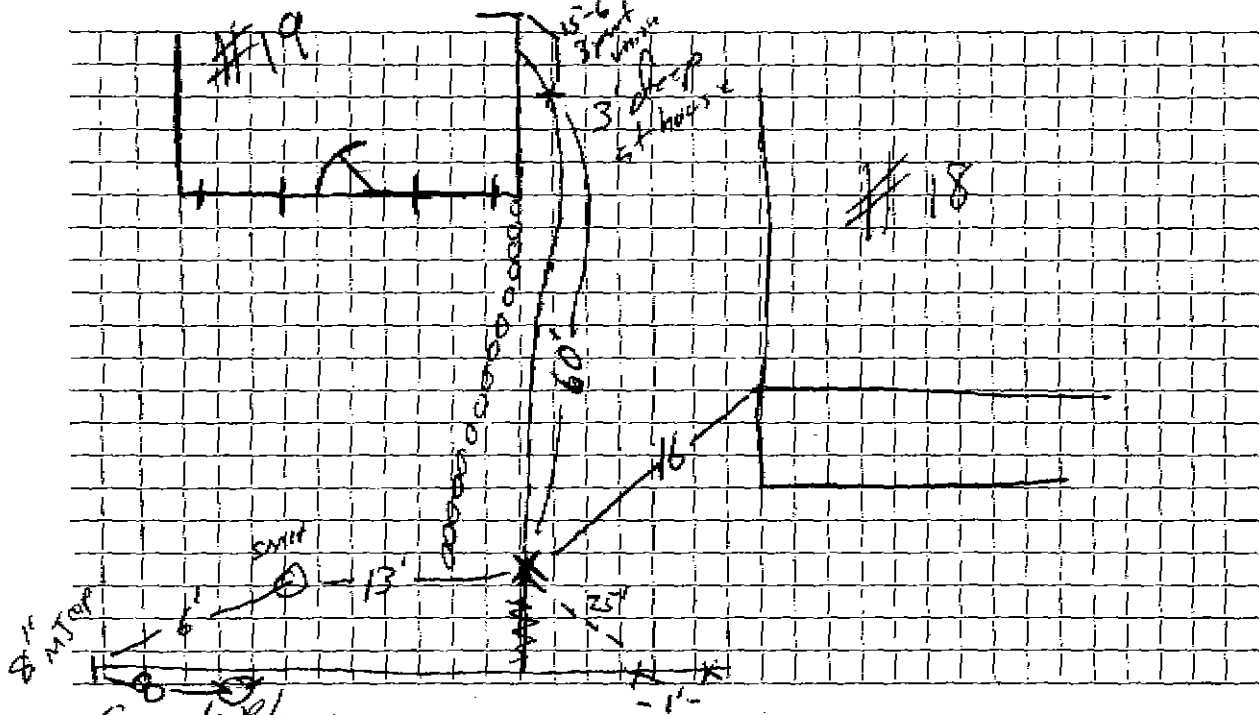

Connection made in *Grant Place* Street. Work completed

Remarks: *3' drop st. house*

.....
.....