

WATER SERVICE RECORD

Name Mary P. Grace

Service No. 25

Address ~~244~~ Grant Place

Location

~~REPAIR~~ - Renewal - ~~WATER SERVICE~~ W.O. # 2486

FEB 10 1975

Date	Material	Amount	Total	Date	Amount	
8-28-74	Labor	44 90		8-28-74	Deposit	100 00
9-10-74	Labor	7 00	51 90	9-10-74	Retard	493
	10% O.H.	5 19	57 09			95 07
17'	3/4" Copper pipe	1 05	17 85		<u>Non-Charge Work</u>	
1	3/4" Wheel Valve		11 13	8-28-74	Labor	151 51
1/2	Yd. Loam		2 50	9-11-74	Labor	39 37
1	Hrs. Town Shovel		6 50	9-10-74	Labor	7 00
			395 07	9-12-74	Labor	43 98
				25'	3/4" Copper pipe @ 1.05	26 25
				1	3/4" Curb Stop	12 45
				1	3/4" Corporation	15 17
				1	Box and Rod	12 95
				1/2	Ton Cold Patch	6 10
				5	Hrs. Trucking @ 3.00	15 00
				3	Hrs. Town Shovel @ 6.50	19 50
				4	Hrs. Trucking @ 1.50	6 00
				1	Hr. Roller @ 2.00	2 00
				2	Hrs. Compressor @ 5.00	10 00
				2	Hrs. Loader @ 4.00	8 00
				1	Patch 30' x 6'	160 00
						\$535.31

Dec 31, 1974

Retire old water service


W.O. # 2960

DATE _____

TOWN OF LEXINGTON — BOARD OF PUBLIC WORKS

WATER DIVISION

Sketch of Service Here

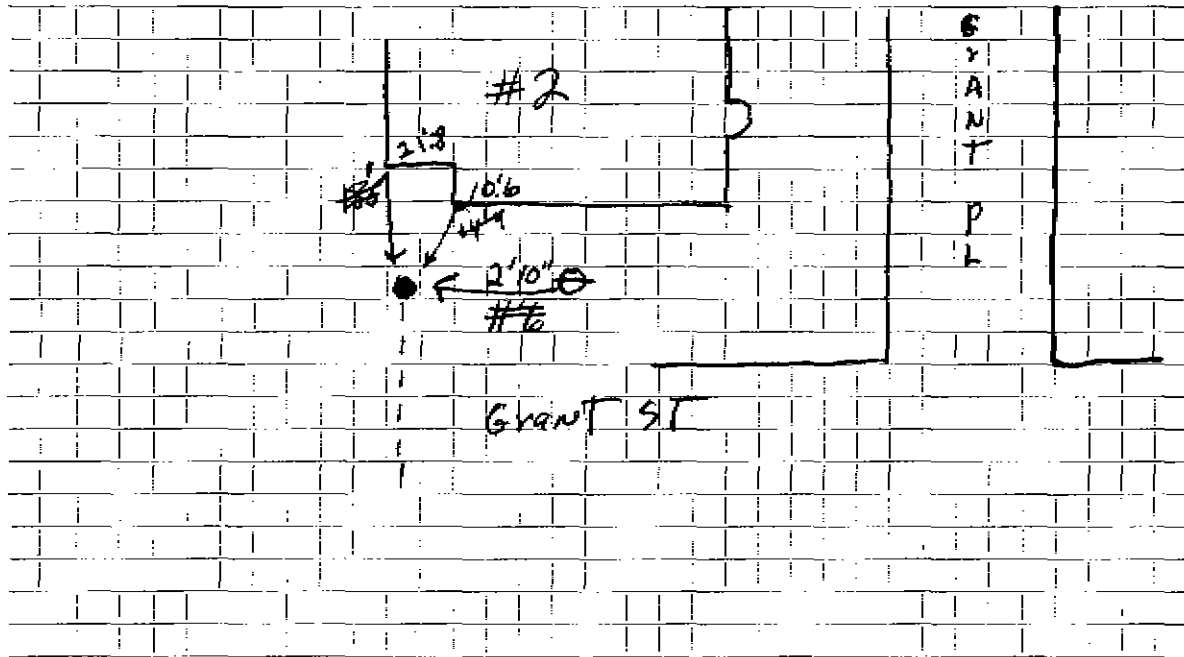

Connection made in Street. Work completed

Remarks:

.....

.....