




DATE \_\_\_\_\_

TOWN OF LEXINGTON — BOARD OF PUBLIC WORKS

WATER DIVISION

Sketch of Service Here  
35 GRANT ST.

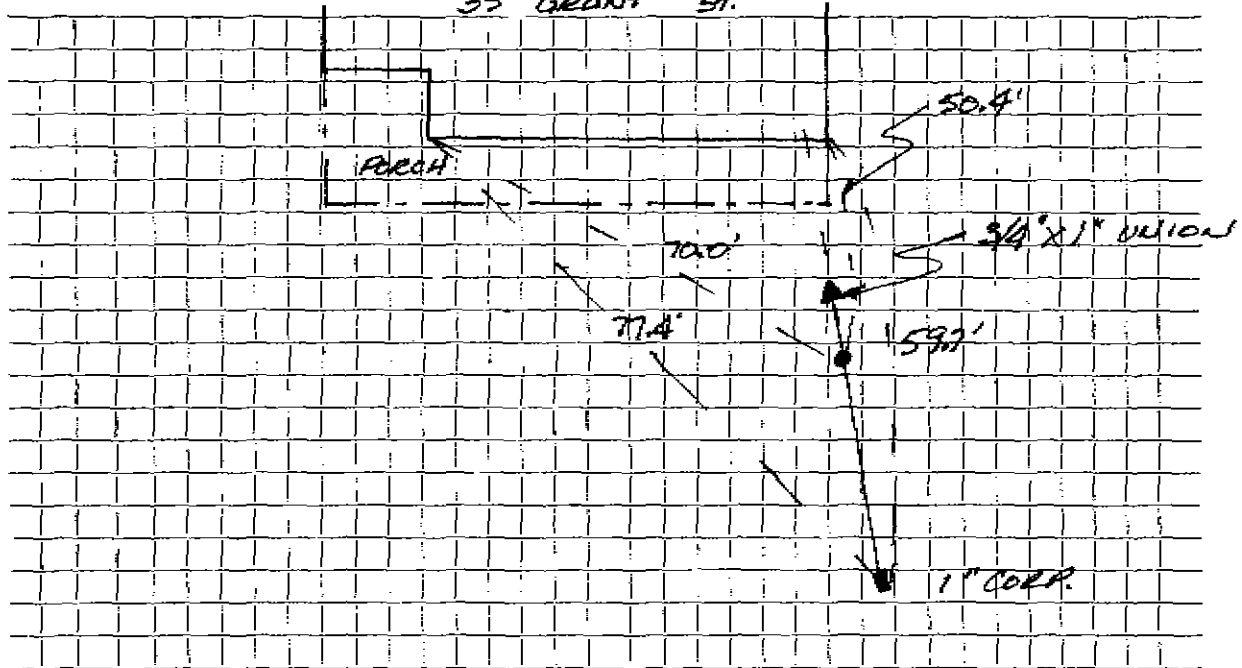

Connection made in ..... Street. Work completed .....

Remarks: .....  
.....  
.....