

WATER SERVICE RECORD

Name Edison Co.

Service No.

90

Address 4th Grant Street

Location Lexington (pit meter)

~~Repair~~ New Service

Com. 7-28-52


Date	Material	Amount	Total	Date	Amount
6/23/52	Labor	47 68		5-19-52	Deposited 175 00
6/24/52	"	50 73	98 41	6-26-52	Paid 64 91
	10% overhead		9 84		239 91
	26' - 2" C.L. Pipe @ .7745		20 14		
	28' - 1" copper tubing @ .4048		11 33		
	4 ^{ea} - 1" C. corp-cocks @ 5.61		22 44		
	1 - 1" Cx 2" I. 4 way branch		19 38		
	2 - 2" L.L. elbows @ 1.83		3 66		
	1 - 2" T.H. gate valve		12 50		
	1 - gate box		14 25		
	1 pit cover and frame		8 71		
	500 brick @ 35.50 M		17 75		
	2 hrs. trucking @ .75		1 50		
			239 91		

DATE _____

TOWN OF LEXINGTON — BOARD OF PUBLIC WORKS

WATER DIVISION

Sketch of Service Here

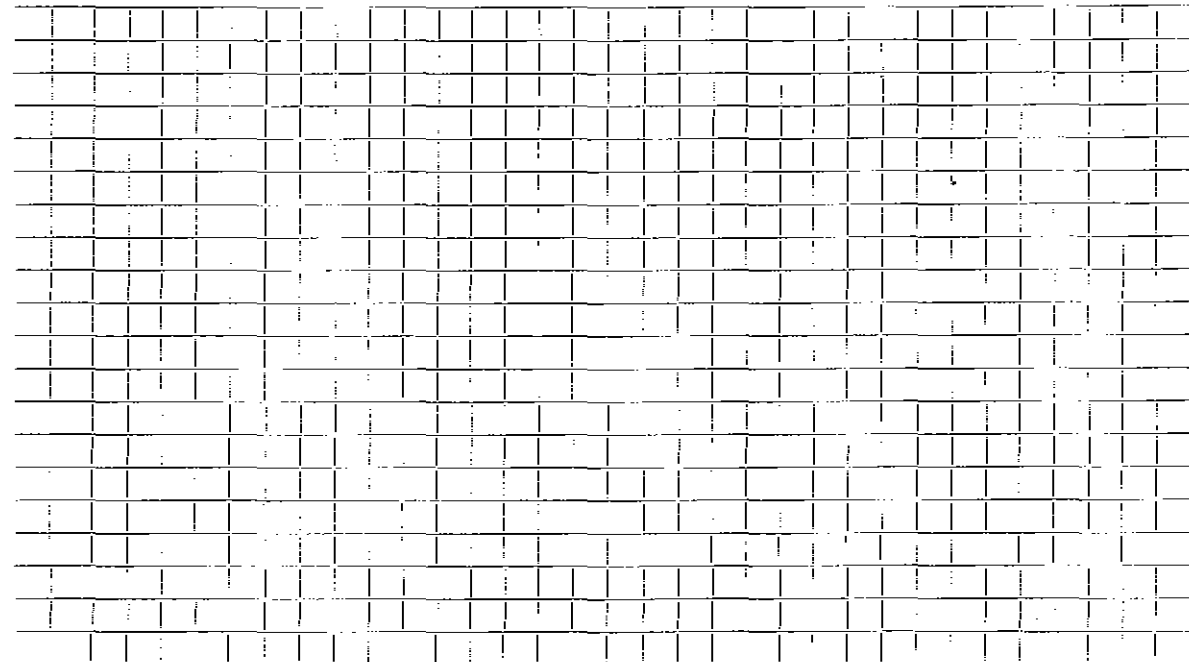

Connection made in Street. Work completed

Remarks:

.....


.....

TOWN OF LEXINGTON — BOARD OF PUBLIC WORKS

WATER DIVISION

DATE _____

Sketch of Service Here

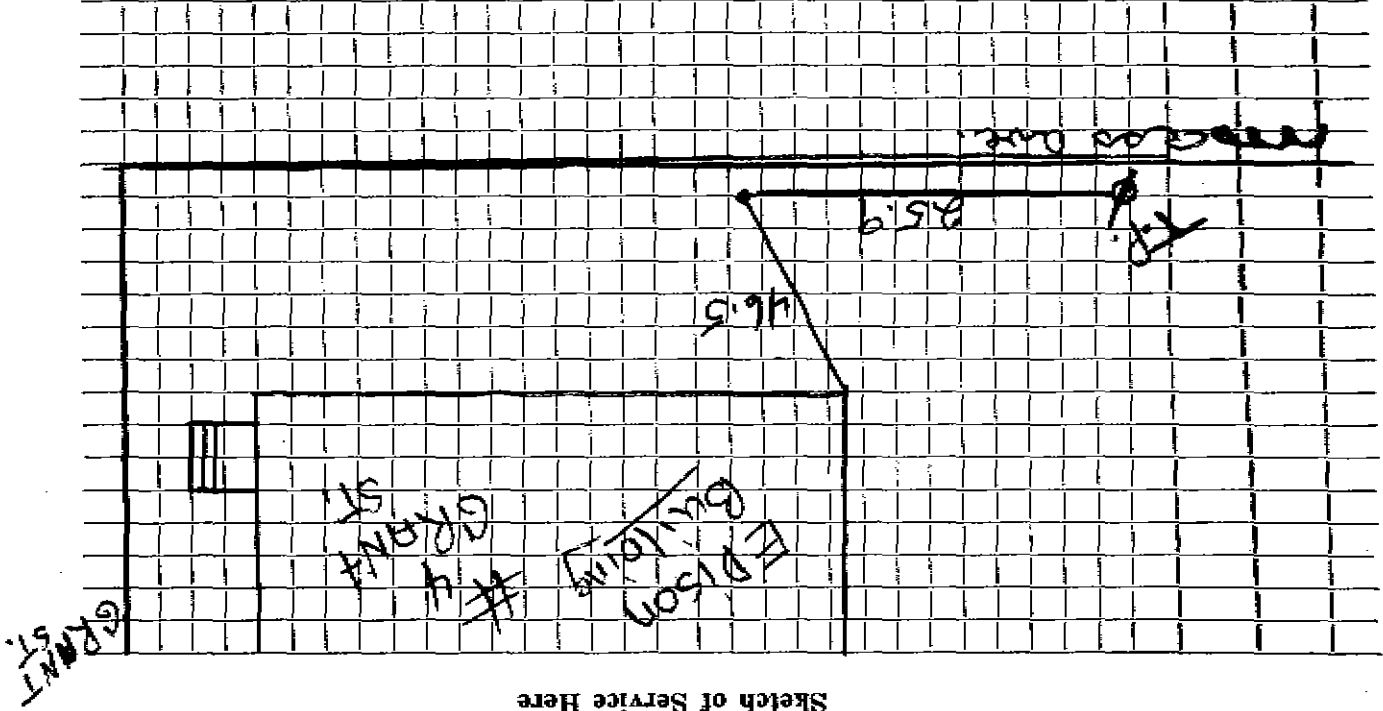

Connection made in _____

Street _____

Work completed _____

Remarks: _____

