




DATE \_\_\_\_\_

TOWN OF LEXINGTON — BOARD OF PUBLIC WORKS  
WATER DIVISION

Sketch of Service Here

41 GRANT ST.

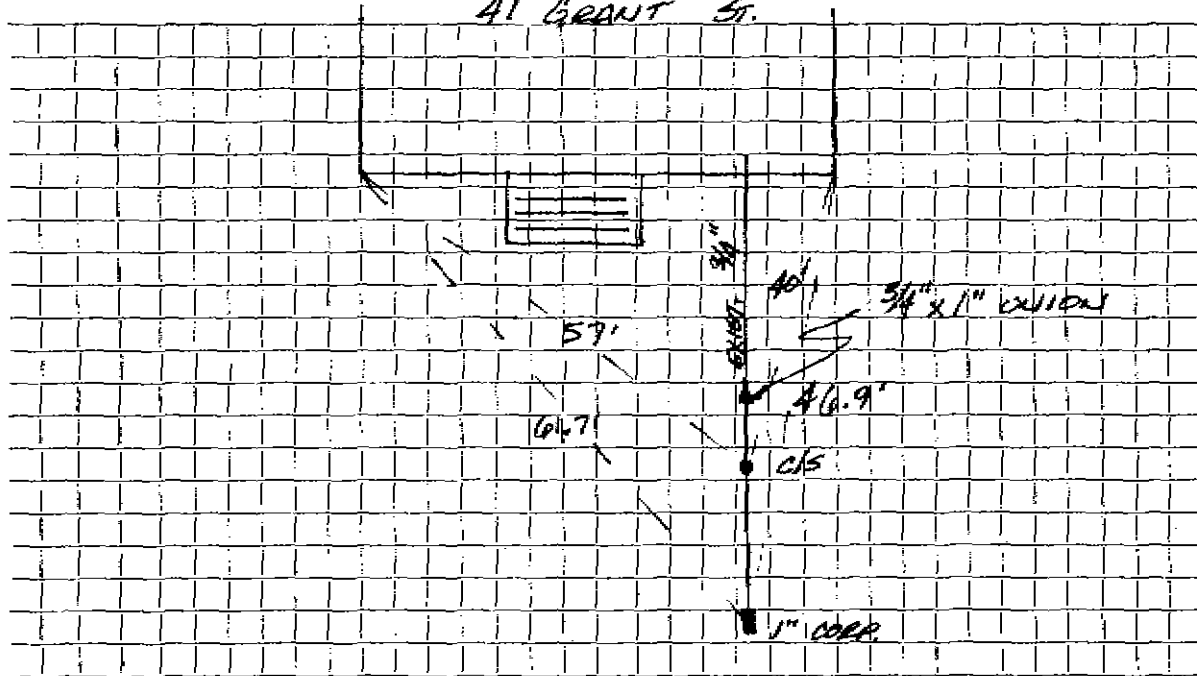

Connection made in ..... Street. Work completed .....

Remarks: .....

.....  
.....