

WATER SERVICE RECORD

Name

Service No.

Address *47 GRANT STREET*

Location

Repair—Renewal—New Service

Date	Material	Amount	Total	Date	OUTSIDE	Amount
4-27-53	40 LF $\frac{3}{4}$ " COPPER			4-18-96	11 LF 1" COPPER	
	1 $\frac{3}{4}$ " x $\frac{1}{2}$ " STOP & WASTE				1 1" COPPERATION	
					1 1" O/S w/ BUFFALO BOX	
					1 $\frac{3}{4}$ " x 1" REDUCER (UNION).	


DATE \_\_\_\_\_

TOWN OF LEXINGTON — BOARD OF PUBLIC WORKS

WATER DIVISION

Sketch of Service Here

47 GRANT ST.

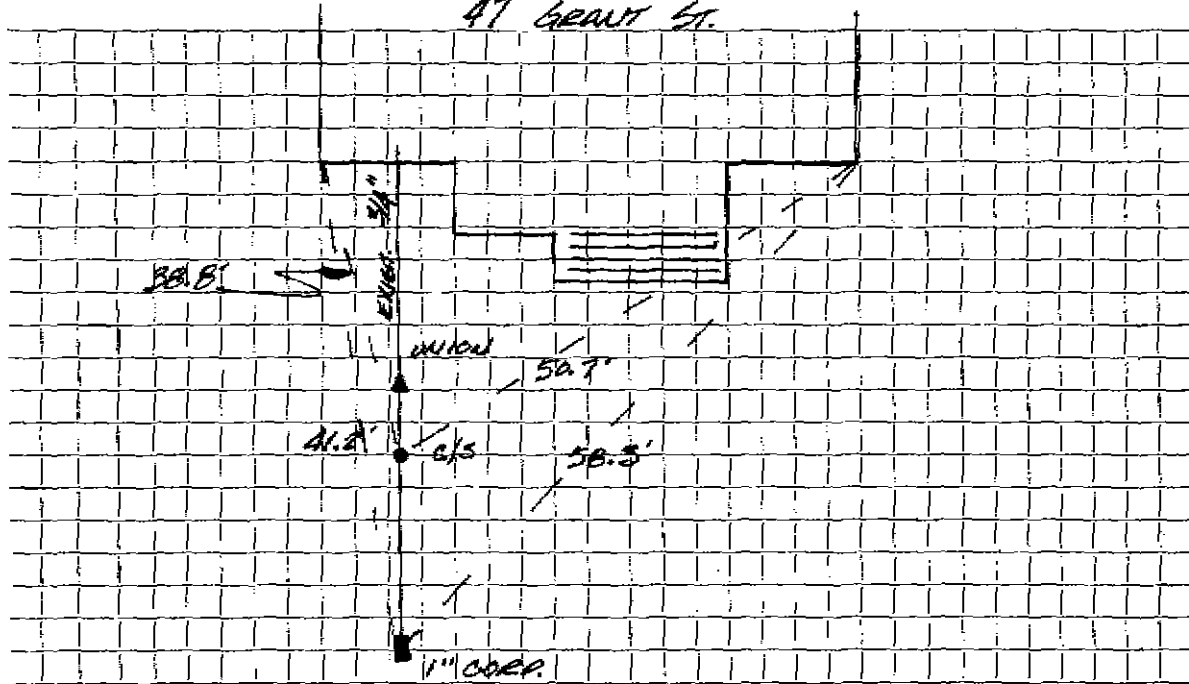

Connection made in ..... Street. Work completed .....

Remarks: .....

.....

.....