




DATE \_\_\_\_\_

TOWN OF LEXINGTON — BOARD OF PUBLIC WORKS

WATER DIVISION

Sketch of Service Here

48 GRANT STREET

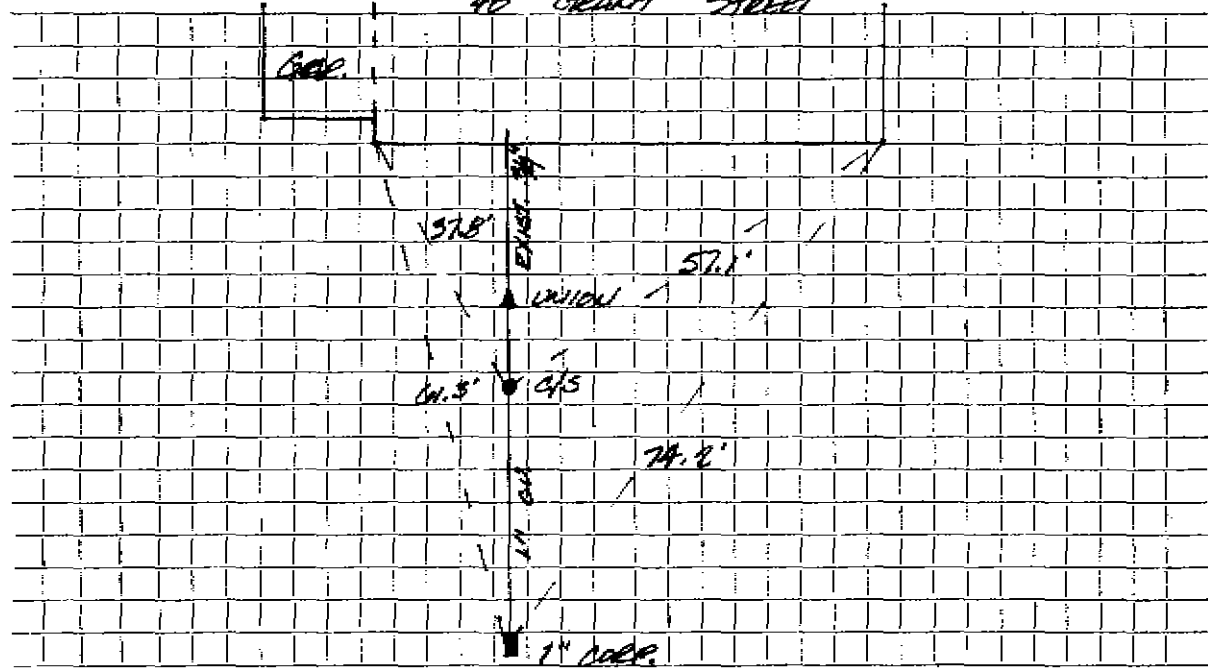

Connection made in ..... Street. Work completed .....

Remarks: ... ORIGINAL ... SERVICE ... 4.27.53 .....