




DATE \_\_\_\_\_

TOWN OF LEXINGTON — BOARD OF PUBLIC WORKS  
WATER DIVISION

Sketch of Service Here  
49 Grant St.

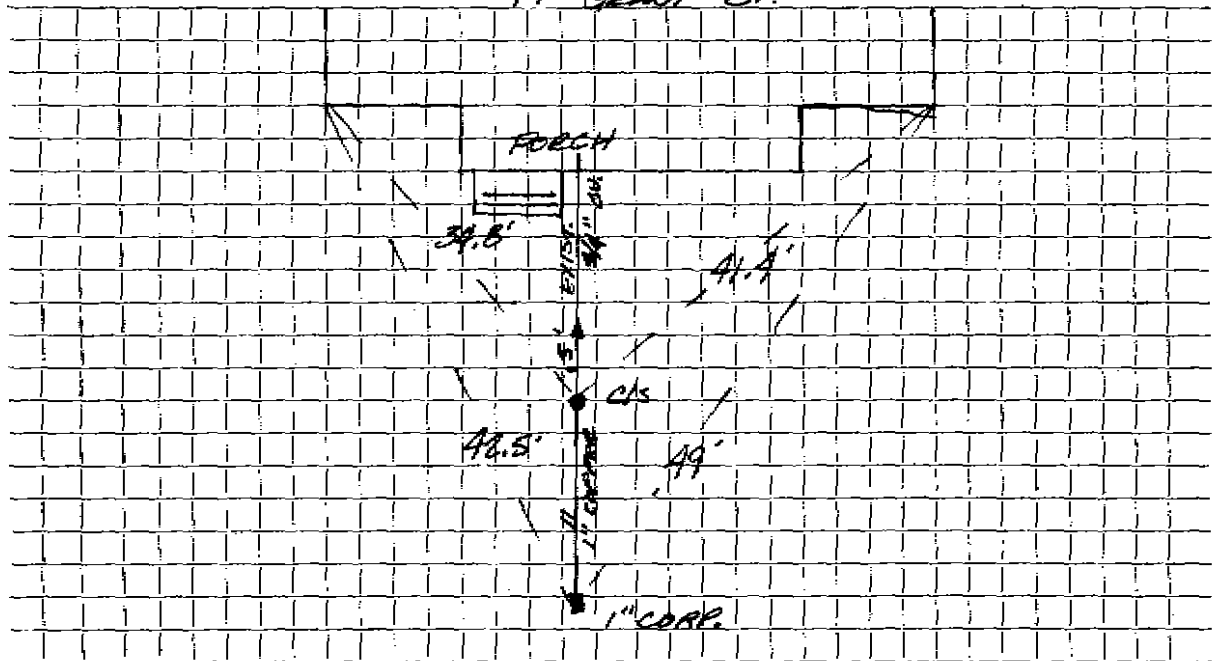

Connection made in ..... Street. Work completed .....

Remarks: ... ORIGINAL SERVICE 5.27.27 .....