

WATER SERVICE RECORD

Name PATRICIA HANSEN

Service No.

Address 100 GRANT STREET

Location


~~Repair~~—~~Renewal~~—~~New Service~~

Date	Material	Amount	Total	Date		Amount
10-8-81	69 LF 1" COOPER			10-20-96		
	1 1" STOP & WAKE				52 LF 1" COOPER	
					1 1" COLPORATION	
					1 1" CURB STOP	
					1 BUFFALO BOX	

DATE 10.20.96

TOWN OF LEXINGTON — BOARD OF PUBLIC WORKS  
WATER DIVISION

Sketch of Service Here

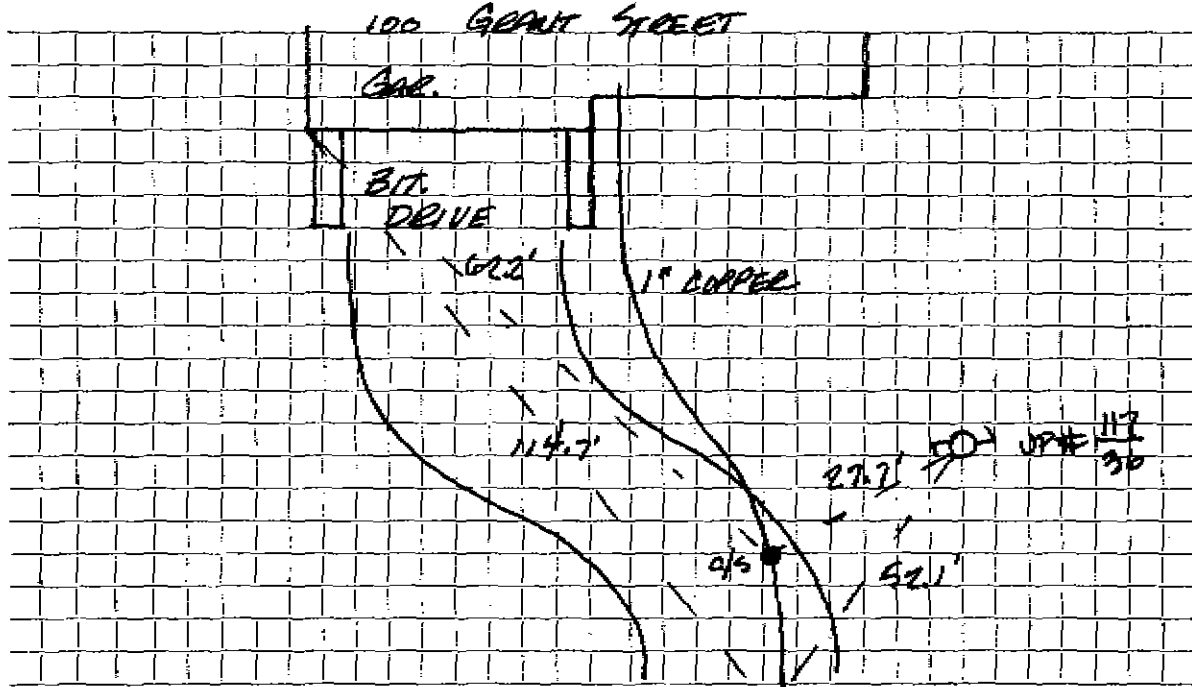

Connection made in GRANT Street. Work completed 1\"/>

Remarks: .....  
.....  
.....

96-2  
CONTRACT 974