

WATER SERVICE RECORD

Name DANIEL GORMAN

Service No.

Address 111 GRANT STREET

Location

Repair—Renewal—New Service


Date	Material	Amount	Total	Date	Amount
4-9-52	LABOR	3 02		24	
	10% OH	30	3 32		
	4/5 LB 3/4" COPPER	.34	15 47		
	1 3/4 x 1/2 STOP & WASTE		4 00		
	1 3/4" UNION		1 72		
	1 HR SHOVEL		7 00		
	1 HR TRUCKING		75		
			<u>32 96</u>		
	PAID 6-16-52				

1 LB 1" COPPER  
 1 1" x 3/4" REDUCER  
 1 1" CFS W/ BOX  
 1 1" COPPERATION

DATE 10.25.76

TOWN OF LEXINGTON — BOARD OF PUBLIC WORKS

**WATER DIVISION**

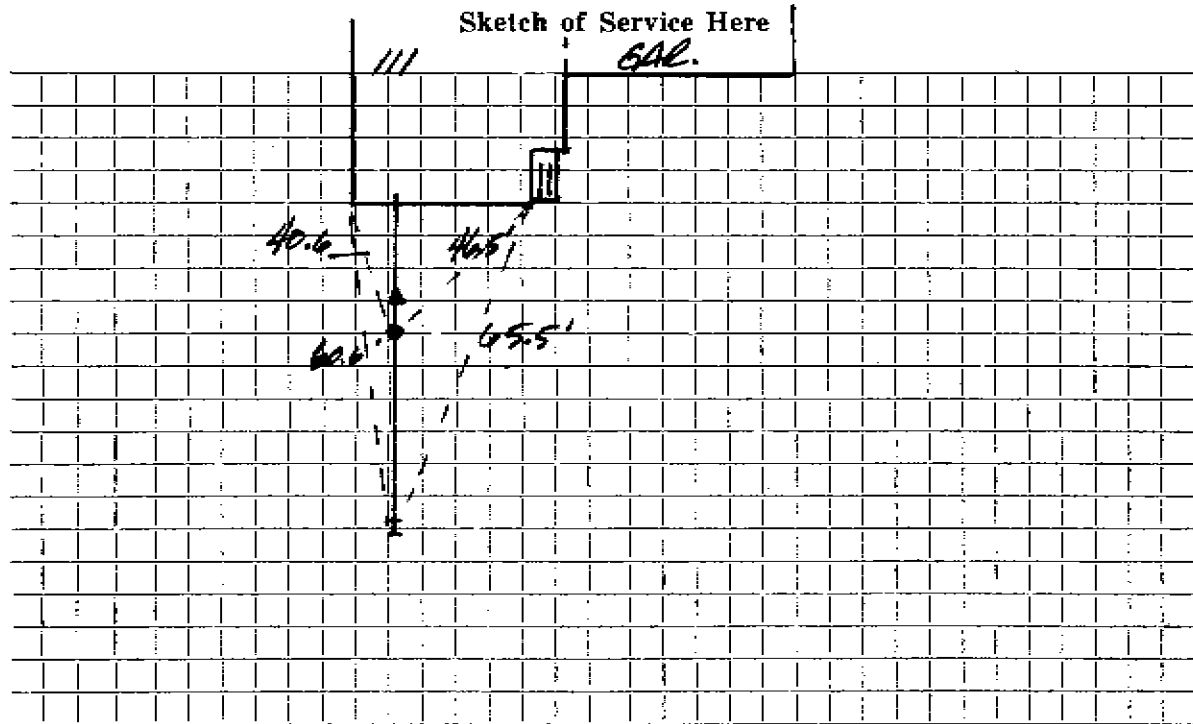

Connection made in Grant Street. Work completed CONTRACT 96-2

Remarks: .....

.....

.....