

WATER SERVICE RECORD

Name *OSCAR W. CARLSON*

Service No.

Address *112 GRANIT STREET*

Location


Repair—Renewal—New Service

Date	Material	Amount	Total	Date	Amount
<i>6-18-62</i>				<i>5-14-97</i>	
	<i>LABOR</i>	<i>4 34</i>		<i>42 LF 1" COPPER</i>	
	<i>10% OH</i>	<i>43</i>	<i>4 77</i>	<i>1 1" COPPERATION</i>	
	<i>60' LF 3/4" COPPER</i>	<i>.42</i>	<i>25 22</i>	<i>1 1" CORB STOP</i>	
	<i>1 3/4" x 1/2 STOP WASTE</i>		<i>6 17</i>	<i>1 1" x 3/4" UNION.</i>	
	<i>1 HR TRUCKING</i>	<i>3 00</i>	<i>3 00</i>		
	<i>6'x3' PATCH</i>		<i>6 00</i>		
			<u><i>45 14</i></u>		
	<i>PAID 6-11-62</i>				

DATE 5/4/97

TOWN OF LEXINGTON — BOARD OF PUBLIC WORKS
WATER DIVISION

Sketch of Service Here

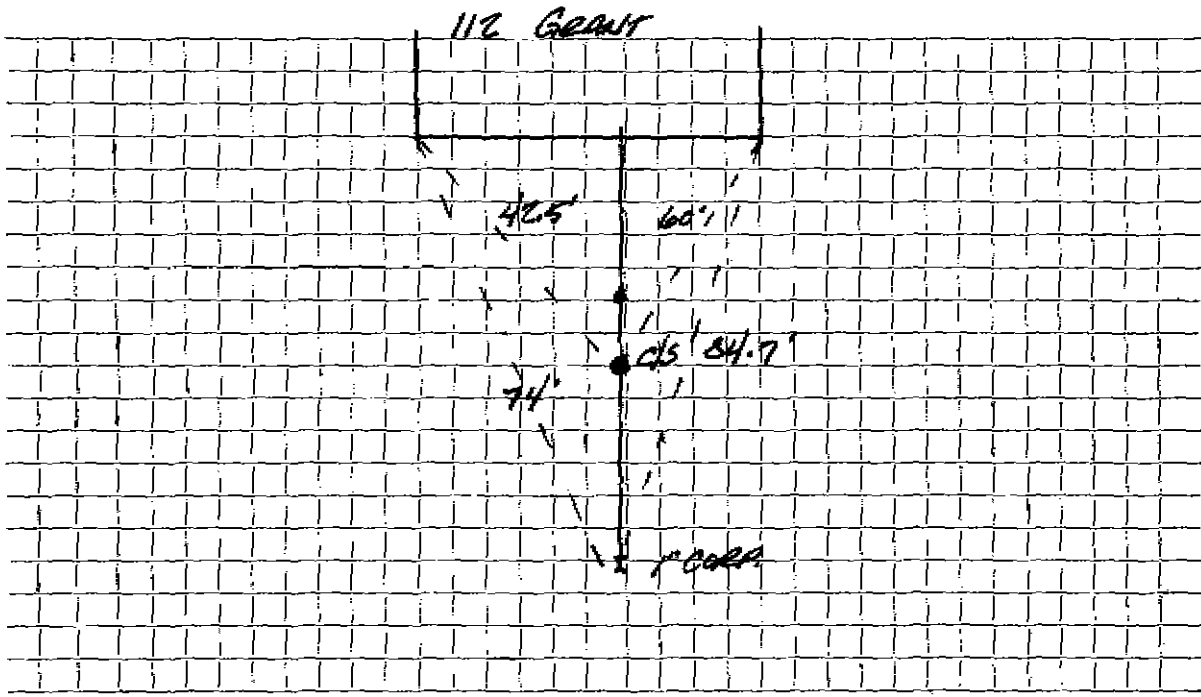

Connection made in GRANT Street. Work completed .. CONTRACT 96-2

Remarks:
.....
.....