

WATER SERVICE RECORD

Name

Service No.

Address 115 GRANT STREET

Location

Repair—Renewal—New Service

Date	Material	Amount	Total	Date	Material	Amount
5.4.56	LABOR	26 40		6.97		
	10% OH	2 64	29 04	21	4 1" COPPER	
	57' 3/4" COPPER	.4850	29 65	1	1" UNION	
	1 3/4" x 1/2" SID		4 96	1	C/S W/ BOX	
	24x3 PATCH		24 00	1	1" COP.	
	1 HR. TRUCKING	75	75			
	1 HR. TWIN SHOVEL	@ 6 00	6 00			
	1 HR TRUCKING	@ 3 00	3 00			
	1 HR ROGER TRAILER	@ 3 00	3 00			
			98 40			
	PWD 10.8.56					


DATE 6-97

TOWN OF LEXINGTON — BOARD OF PUBLIC WORKS

WATER DIVISION

Sketch of Service Here

115 GRANT ST.

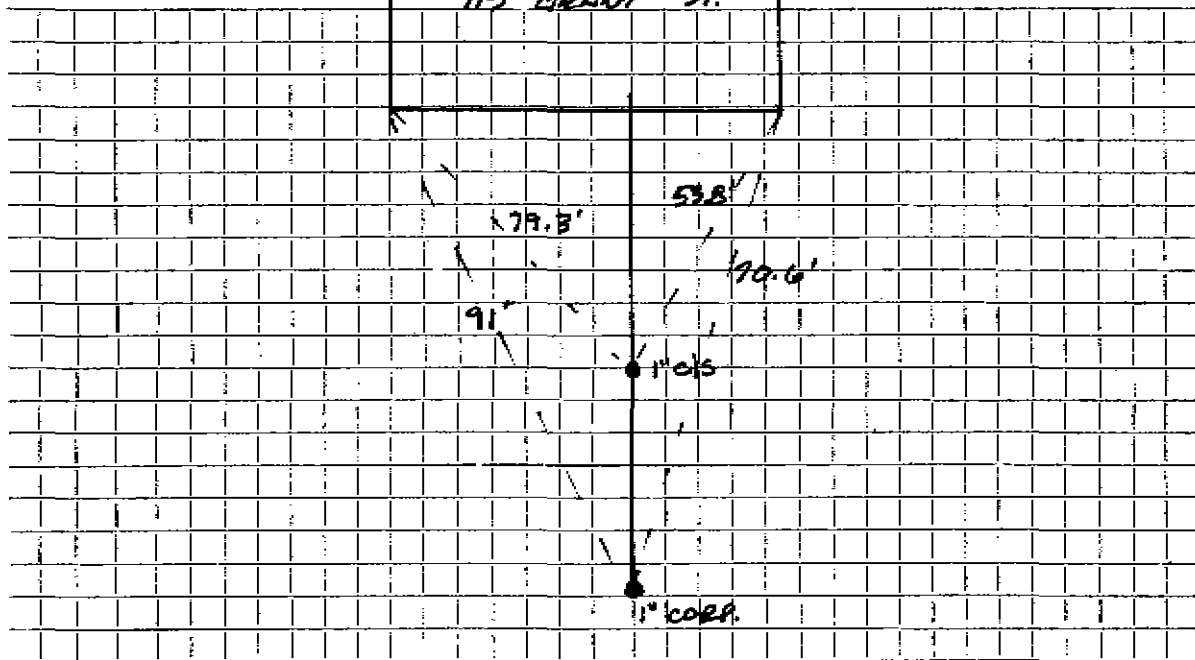

Connection made in ..... Grant Street. Work completed ..... CONTRACT 96-2 .....

Remarks: .....  
.....  
.....