

WATER SERVICE RECORD

Name

Service No.

Address 118 GRANT STREET

Location

Repair ~~Renewal~~ New Service


Date	Material	Amount	Total	Date	Amount
12-1-01	LABOR	7.36		6-97	
	10% ON	.74	8.10		
	120 LB 3/4" COPPER	.42	50.40		35 LB 1" COPPER
	1 3/4 X 1/2 WITH 5/8"		6.19		1 3/4 X 1" UNION
	1 3/4 X 3 PART UNION		2.41		1 CORPORATION 1"
	1 HR. TUCKING	3.00	3.00		1 1" C/S W/ BUFFALO BOX
	3 X 3 PATCH		3.00		
			73.08		
	PAID 3-5-02				

DATE 6-97

TOWN OF LEXINGTON — BOARD OF PUBLIC WORKS

WATER DIVISION

Sketch of Service Here

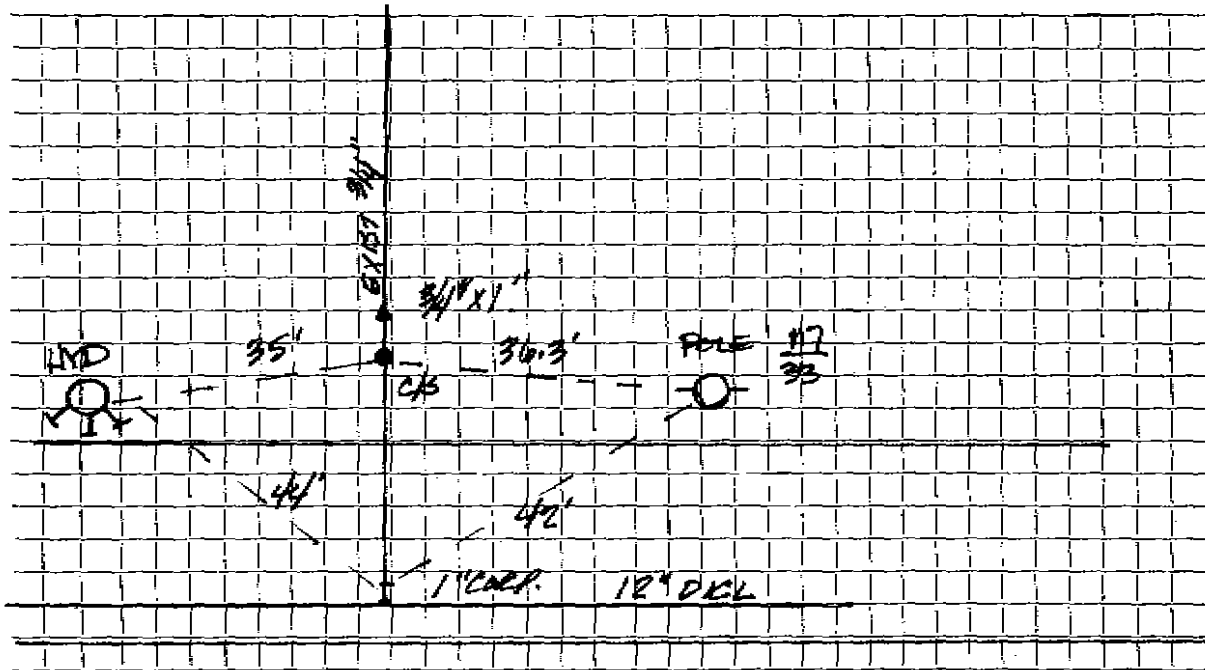

Connection made in GRAVE Street. Work completed CONTRACT 96-2

Remarks:
.....
.....