

WATER SERVICE RECORD

Name

Service No.

Address

119 GRANT STREET

Location

Repair Renewal New Service

Date	Material	Amount	Total	Date	Amount
5-2-66	LARDER	51.20	56.32 15.00 .60 .60 .75 .52 3.00 6.50 84.09	6-9-77	
	10% OIL	5.12		20 LF 1" COPPER	
	20 LF 3/4" COPPER			1 C/S BOX	
	1 1/2" COUPLING			1 1" UNION	
	1 1/2" NIPPLE			1 1" CORP	
	1/4 YARD LOAM				
	1/2 BRASS WED				
	1/2 IR TRUCKING				
	1 IR TRACTOR				
INSIDE	4" H-STEEL				
11/13/98	24' 1" COPPER				
	1" VALVE				
	FJ WALSH				


DATE 6-97

TOWN OF LEXINGTON — BOARD OF PUBLIC WORKS

WATER DIVISION

Sketch of Service Here

119 GRANT ST.

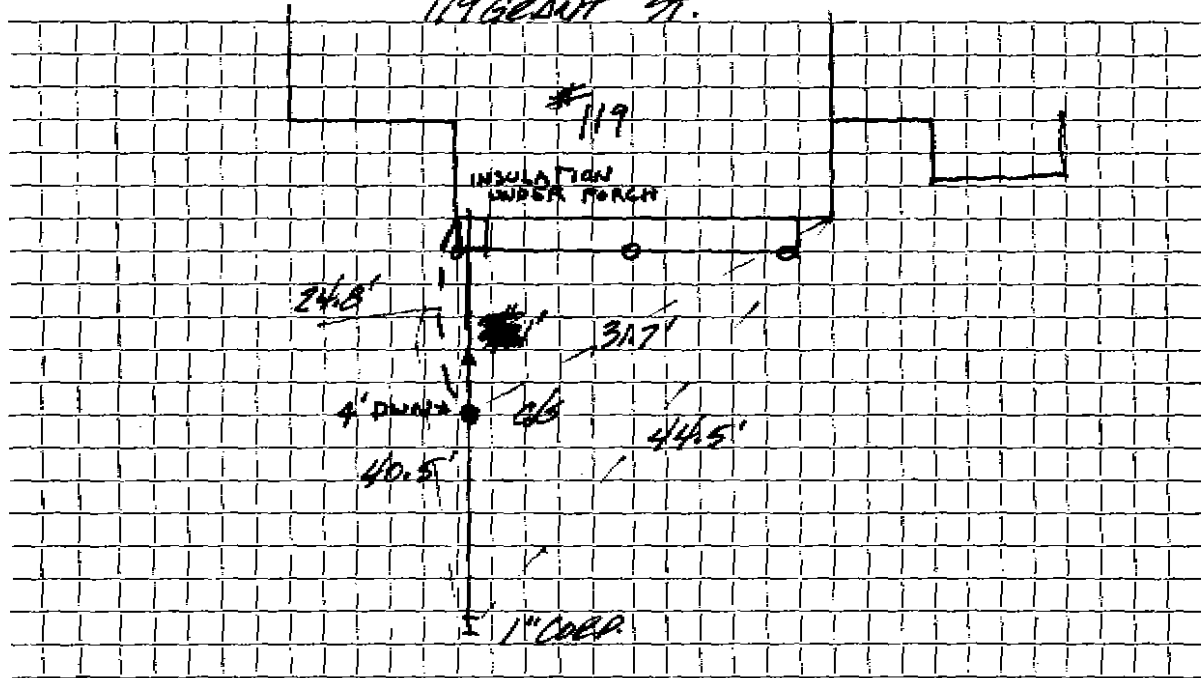

Connection made in GRANT Street.

Work completed CONTRACT 90-2

Remarks:
.....
.....