

WATER SERVICE RECORD

Name

Service No.

Address 122 GRANT STREET

Location


Repair—Renewal—New Service

Date	Material	Amount	Total	Date	Amount
1-3-50	LOBOC	2.70		6-97	
	10% OIL	.27	2.97	33	LE 1" COPPER
58	LE 3/4 COPPER	.23	13.94	1	1" UNION
1	3/4 X 1/2 (W/1) S/W		3.29	1	1" C/S W/B. BOX
1	HE SHOVEL		7.00	1	1" CORPORATION.
1	HE TRUCKING		.75		
	20X3 PATCH.		20.00		
			47.95		
	PAID 12-29-49				

DATE 6.97

TOWN OF LEXINGTON — BOARD OF PUBLIC WORKS  
**WATER DIVISION**

Sketch of Service Here

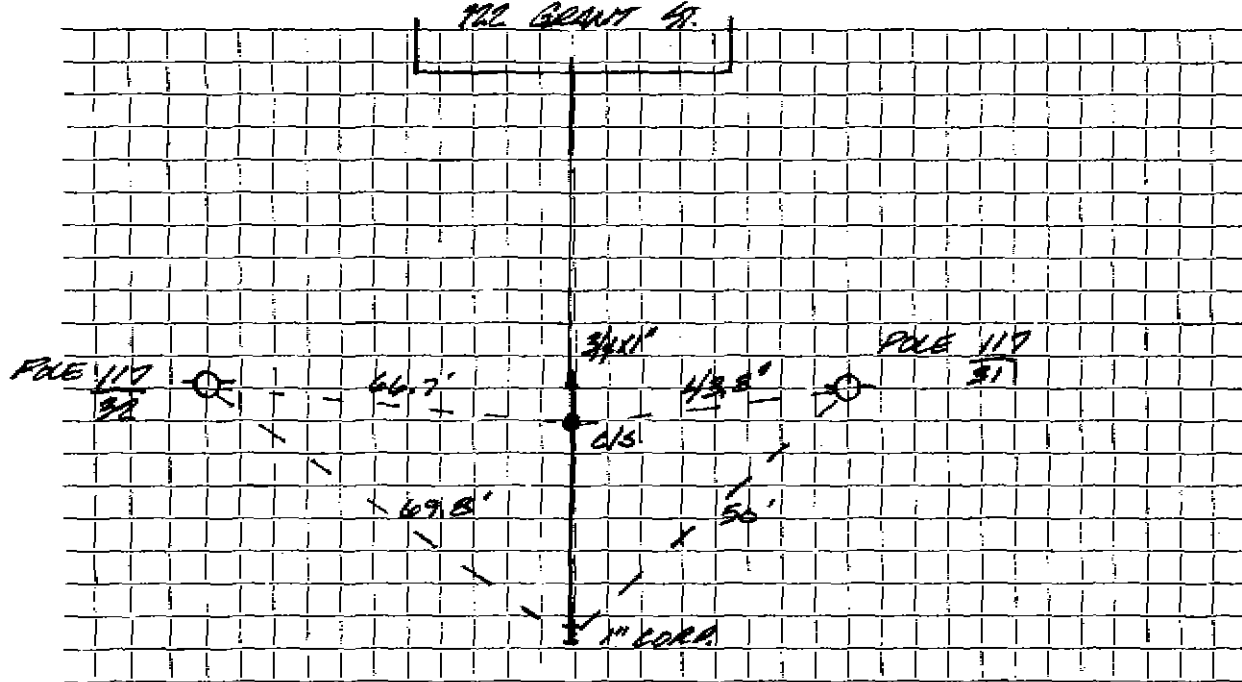

Connection made in ..... GRANT ..... Street. Work completed ..... CONTRACT 96-2 .....

Remarks: .....  
.....  
.....