

WATER SERVICE RECORD

Name

Service No.

Address 123 GRANT STREET

Location


Repair Renewal New Service

Date	Material	Amount	Total	Date	Material	Amount
5.14.62	LABOR	2 13		6.97		
	10% OH	21	2 34	22	LF 1" COPPER	
26	LF 3/4" COPPER	12	10 92	1	1" UNION	
1	3/4 x 1/2" 10# S.W.		6 17	1	1" C/S W/ BRASS BOX	
			19 43	1	3/4" COPPER - 1"	
	PAID 5.7.62					

DATE 6.97

TOWN OF LEXINGTON — BOARD OF PUBLIC WORKS
WATER DIVISION

Sketch of Service Here

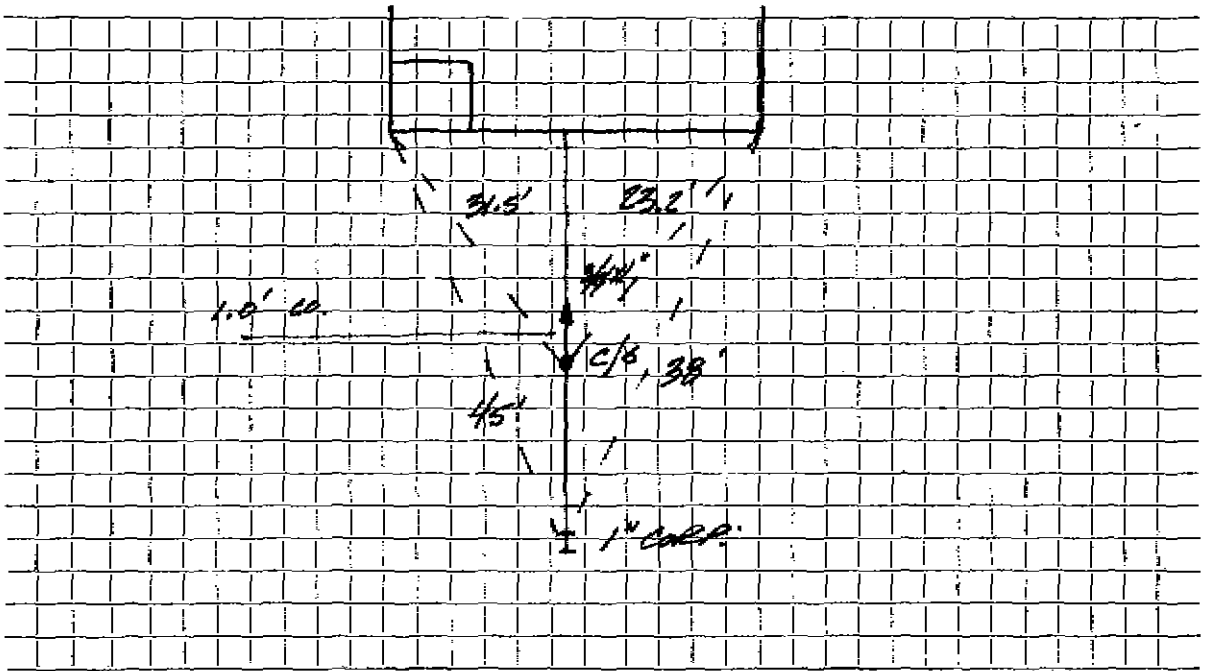

Connection made in GRAVE Street. Work completed CONTRACT 96-2

Remarks:

.....

.....