

**WATER SERVICE RECORD**

Name

Service No.

Address *124 GRANT STREET*

Location

Repair—Renewal—New Service


Date	Material	Amount	Total	Date	Amount
<i>12-23-48</i>	<i>LABOR</i>	<i>5.07</i>	<i>5.07</i>	<i>6.97</i>	
	<i>10% O.W.</i>	<i>51</i>	<i>.51</i>	<i>33</i>	<i>LE 1" COPPER</i>
<i>50</i>	<i>LE 3/4" COPPER</i>	<i>.255</i>	<i>12.75</i>	<i>1</i>	<i>1" COPP.</i>
<i>1</i>	<i>3/4x1/2" 14H SKI</i>	<i>.</i>	<i>3.16</i>	<i>1</i>	<i>3/4x1" UNION</i>
<i>4</i>	<i>HRS. SHOVEL</i>	<i>7.00</i>	<i>28.00</i>	<i>1</i>	<i>C/S W/B. BOX.</i>
<i>1</i>	<i>HR. TRUCK</i>		<i>.75</i>		
<i>22</i>	<i>X3' PATCH.</i>		<i>22.00</i>		
			<i>72.25</i>		
	<i>PAID 12-18-48</i>				

DATE 6.97

TOWN OF LEXINGTON — BOARD OF PUBLIC WORKS

WATER DIVISION

Sketch of Service Here  
124 GRANT ST.

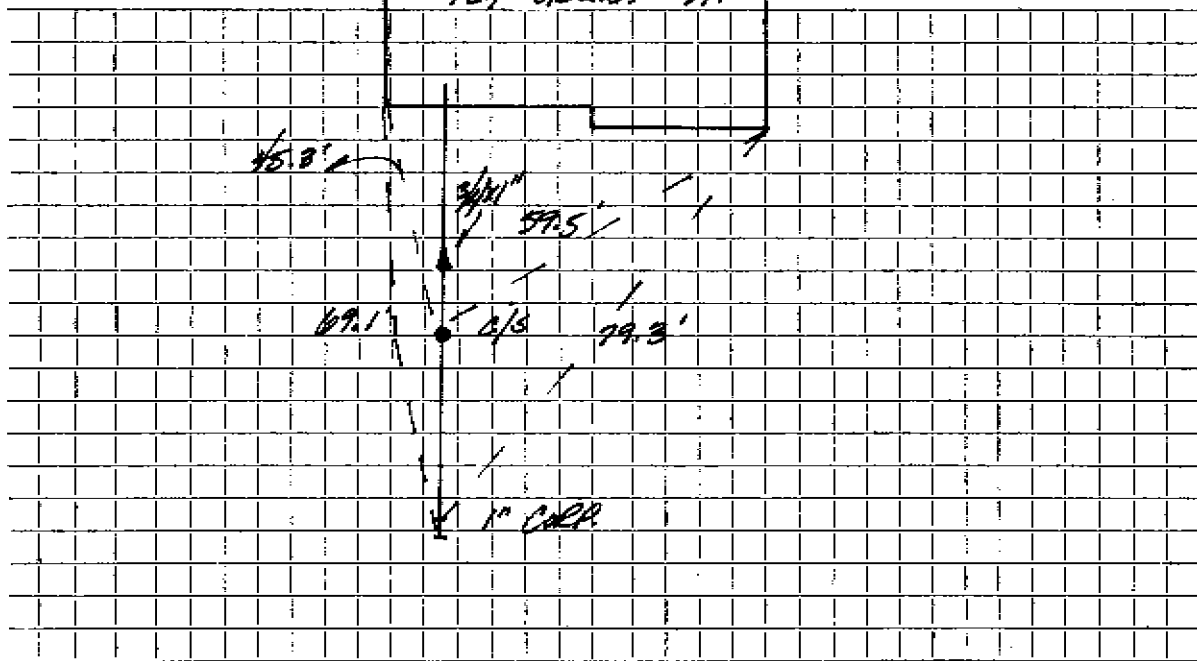

Connection made in ..... GRANT Street.

Work completed ..... CONTRACT 962

Remarks: .....  
.....  
.....