

WATER SERVICE RECORD

Name

Service No.

Address 125 GRANT STREET


Location

Repair Renewal New Service

| Date | Material | Amount | Total | Date | Amount |
|---------|--------------|--------|-------|---------------------|--------|
| 9-11-07 | LABOR | 24.68 | | 5-97 | |
| | 10% OH | 2.47 | 27.15 | 20 LF 1" COPPER | |
| 15 | LF 1" COPPER | .79 | 11.85 | 1 C/S W/B. BOX - 1" | |
| 1 | HR. TRUCK | | 3.00 | 1 1" UNION | |
| 2 | HRS. SHOVEL | 6.50 | 13.00 | 1 1' COP. | |
| | | | 55.00 | | |
| | PAID 9-6-07 | | | | |

DATE 5.97

TOWN OF LEXINGTON — BOARD OF PUBLIC WORKS
WATER DIVISION

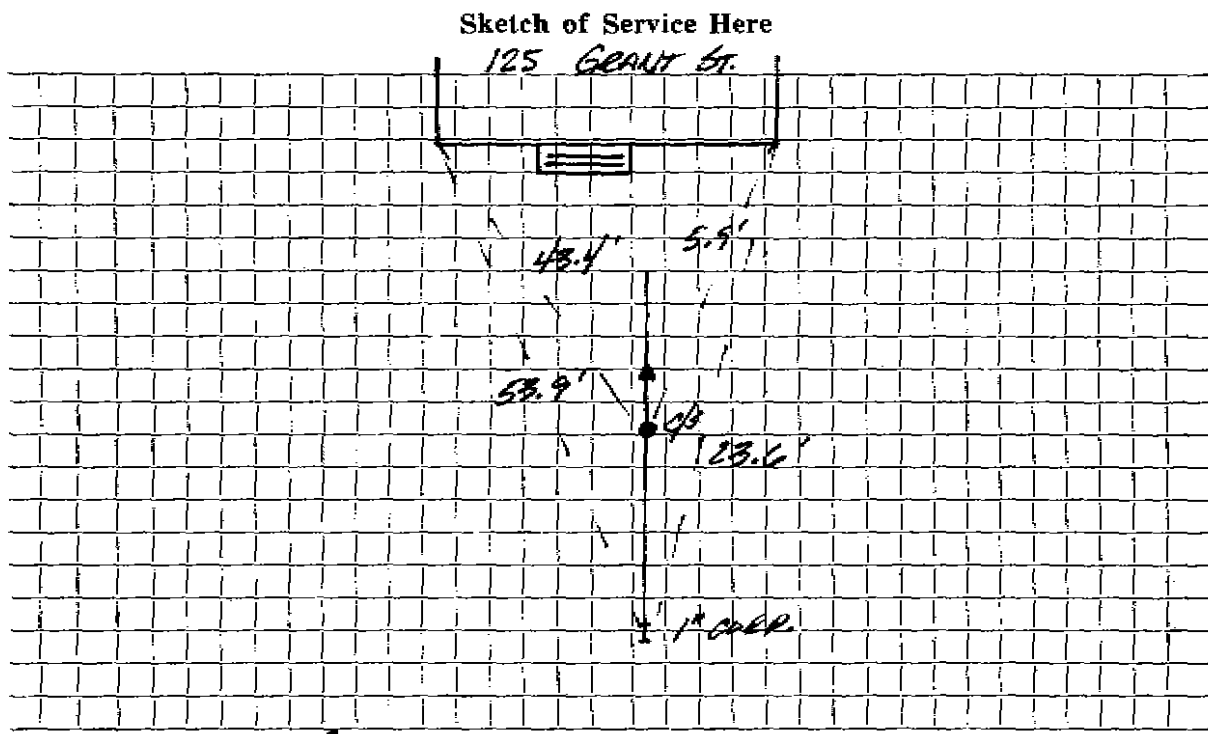

Connection made in GRANT Street. Work completed CONTRACT 962

Remarks:

.....

.....