

WATER SERVICE RECORD

Name

Service No.

Address 126 GRANT STREET

Location


Repair Renewal New Service

Date	Material	Amount	Total	Date	Material	Amount
5.14.58	LABOR	34.89		6.97		
	10% OH	3.49	38.38		35 LF 1" COPPER	
	60 LF 3/4" COPPER	.57	21.20		1 1" CORPORATION	
	1 3/4" x 1/2" NUTS STD		5.84		1 1" C/S w/B. BOX	
	3 HRS TRUCKING		2.25		1 1" x 3/4" UNION	
	2 HRS SHOVEL		19.00			
	20 X3 PICH		20.00			
			101.67			
	PAID 5.13.58					

DATE 6.97

TOWN OF LEXINGTON — BOARD OF PUBLIC WORKS
WATER DIVISION

Sketch of Service Here

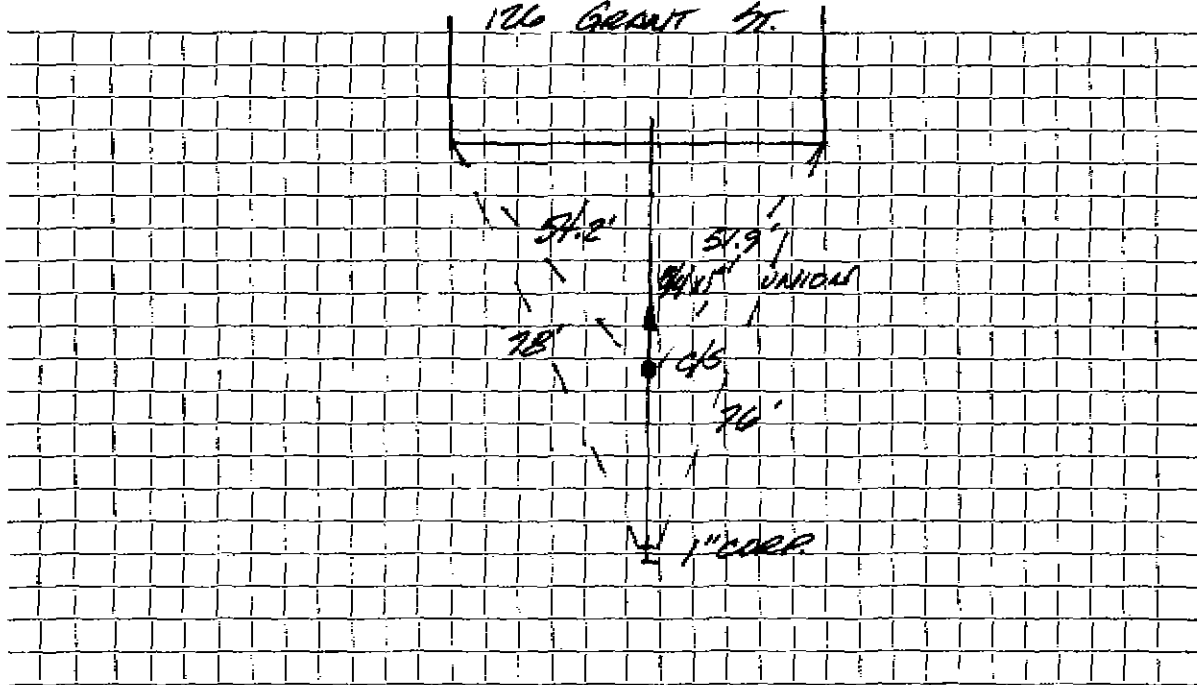

Connection made in GRANT Street. Work completed CONTRACT 96-2

Remarks:

.....

.....