

WATER SERVICE RECORD

Name

Service No.

Address *132-134 GRANT STREET*

Location

Repair—Renewal—New Service


Date	Material	Amount	Total	Date	Amount
<i>9-2-52</i>	<i>LABOR</i>	<i>2.00</i>		<i>6-97</i>	
	<i>10% OH</i>	<i>.70</i>	<i>2.70</i>		<i>30 LF 1" COPPER</i>
	<i>15 LF 3/4" COPPER</i>	<i>.34</i>	<i>5.10</i>		<i>1 1" COPPERATION</i>
	<i>1 3/4" x 1/2" UNH SW</i>		<i>4.00</i>		<i>1 1" x 3/4" UNION</i>
	<i>1 HR TRUCKING</i>		<i>.75</i>		<i>1 C/S W/BOX - 1"</i>
			<i>17.55</i>		
	<i>PAID 8-13-52</i>				

DATE 6-97

TOWN OF LEXINGTON — BOARD OF PUBLIC WORKS

WATER DIVISION

Sketch of Service Here
132/134 GRANT ST.

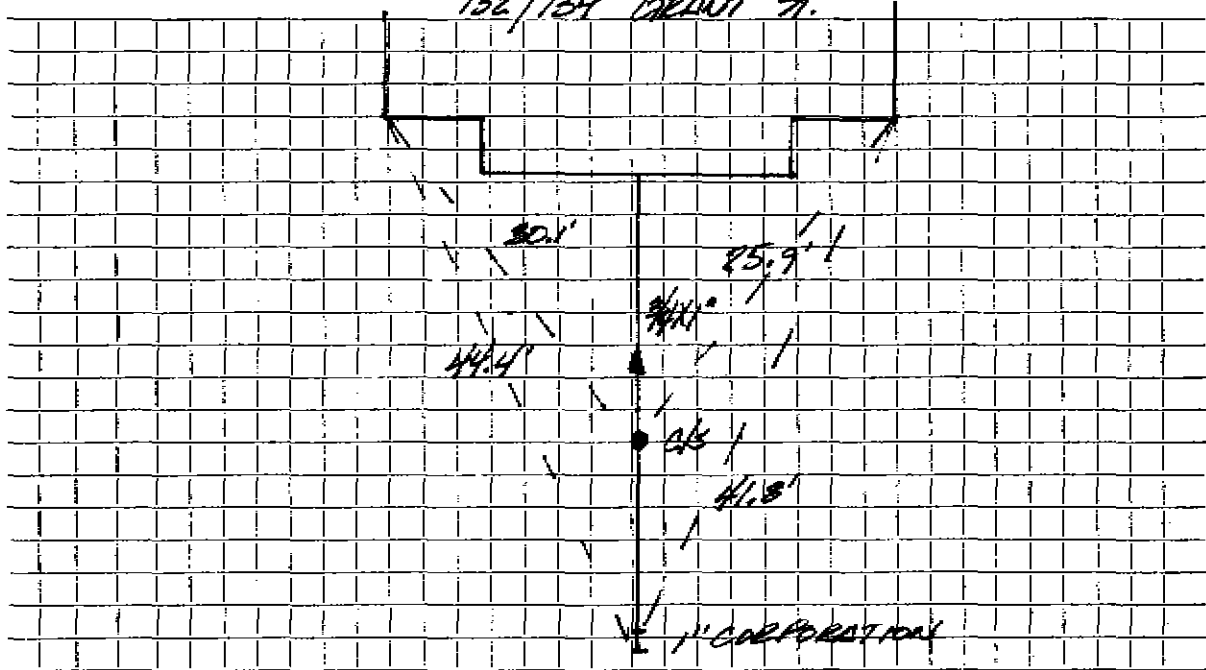

Connection made in *GRANT* Street.

Work completed *CONTRACT 96-2*

Remarks:

.....

.....