


TOWN OF LEXINGTON — BOARD OF PUBLIC WORKS
WATER DIVISION

Sketch of Service Here

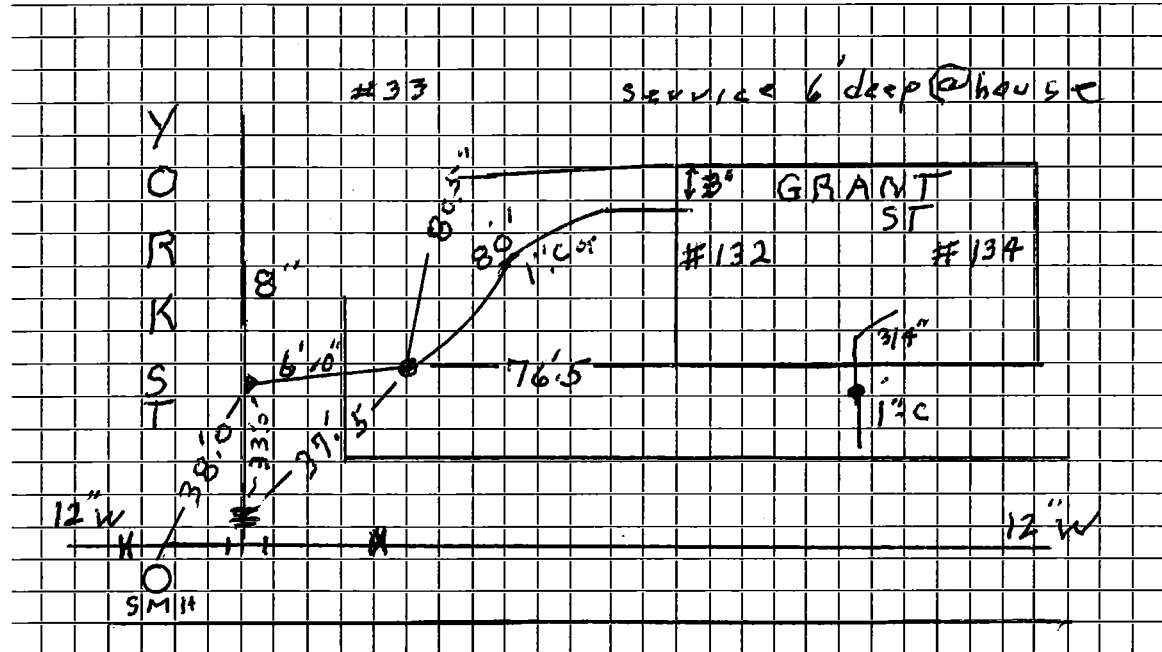

Connection made in YORK ST Street. Work completed 5/26/11 J.McI

Remarks: 8" W - GRANT - TO 33 YORK ST

.....

.....