

WATER SERVICE RECORD

Name

Service No.

Address 130 + 13B GRANT STREET

Location

Repair ~~Renewal~~ New Service

Date	Material	Amount	Total	Date	Amount
9-22-70	LABOR	45 92		7-77	
9-25-70	"	63 95		35 LF 1" COPPER	
10-7-70	"	25 74	155 21	1 1" UNION	
	10% OH		13 52	1 1" C/S W/BOX	
	67 LF 1" COPPER		69 09	1 1" CORPORATIO W	
	1 1" WHEEL VALVE		12 53		
	1 1" UNION		2 21		
	6 YDS LOAM		21 00		
	1/2 HOT MIX		7 00		
	3 HRS. TRUCK		9 00		
	1 HR COMPRESSOR		5 00		
	4 HRS. SHOVEL		26 00		
	1/2 HR ROLLER		1 00		
	TRAILER		2 00		
			<u>306.76</u>		
	PAID 11-25-70				


DATE 7.97

TOWN OF LEXINGTON — BOARD OF PUBLIC WORKS

WATER DIVISION

GRANT STREET

Sketch of Service Here

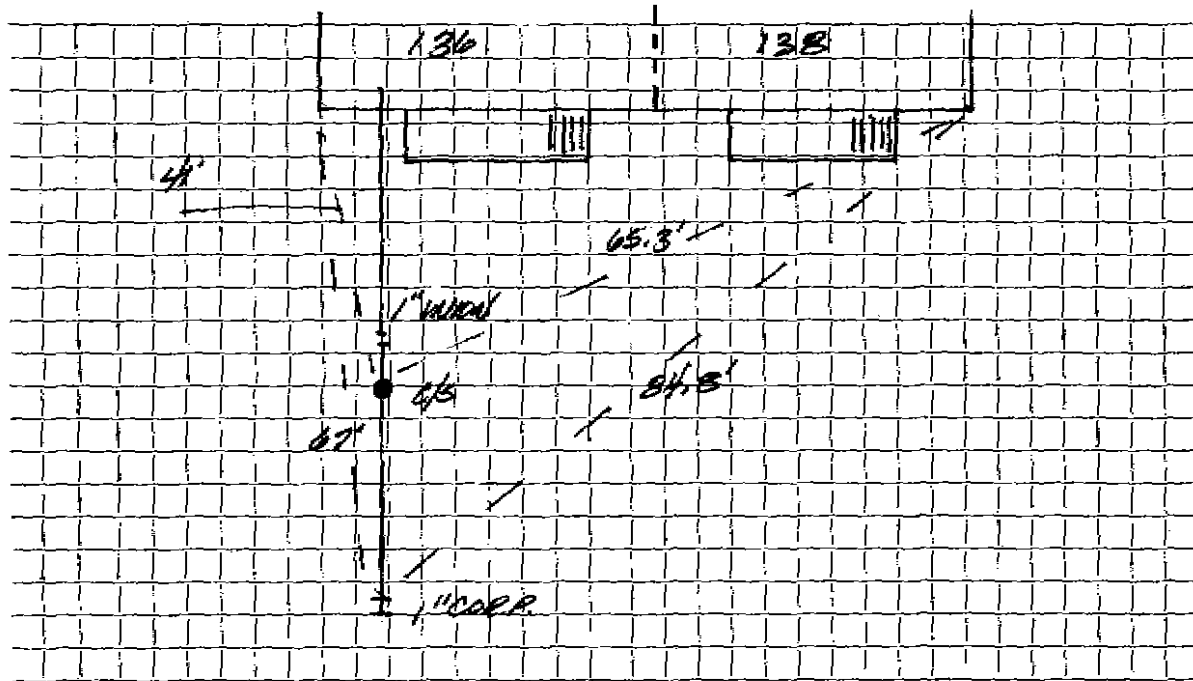

Connection made in Grant Street. Work completed Contract 96-2

Remarks:

.....

.....